



ABERF\_763

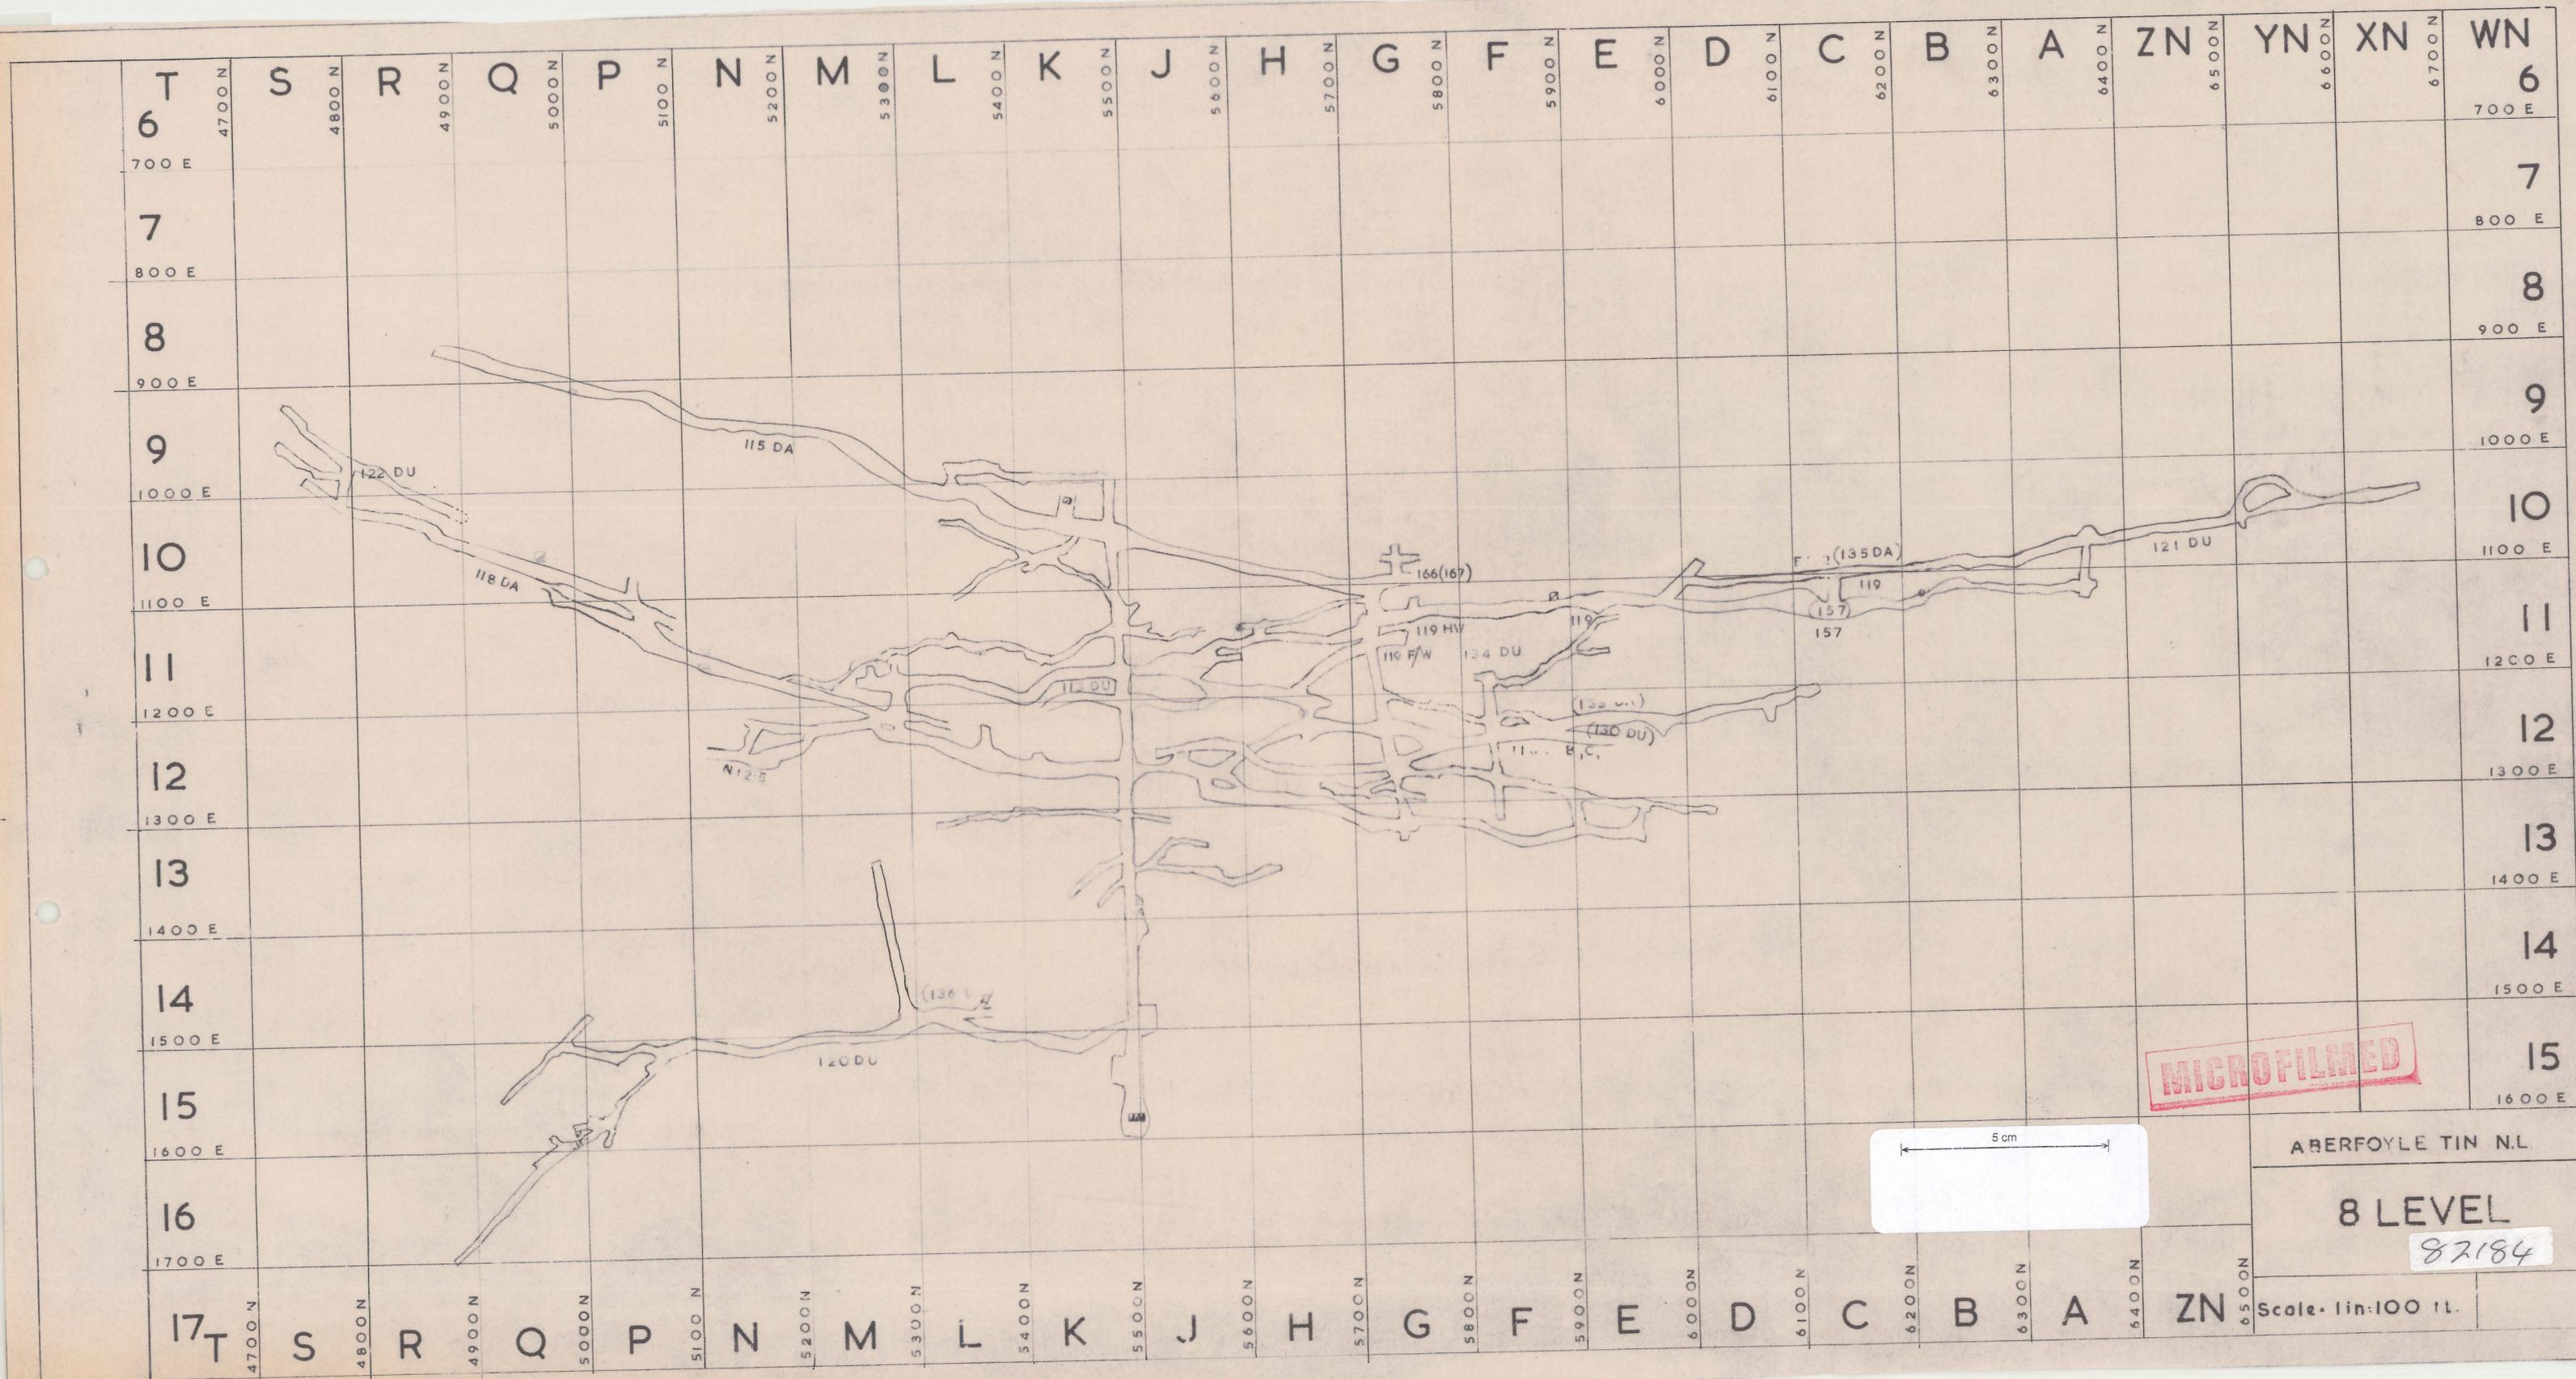

MICROFILMED

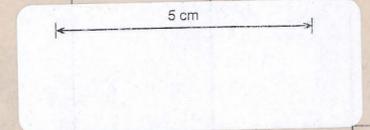

ABERFOYLE TIN N.L.

8 LEVEL

82184

Scale: 1 in. = 100 ft.