



ABERF_771

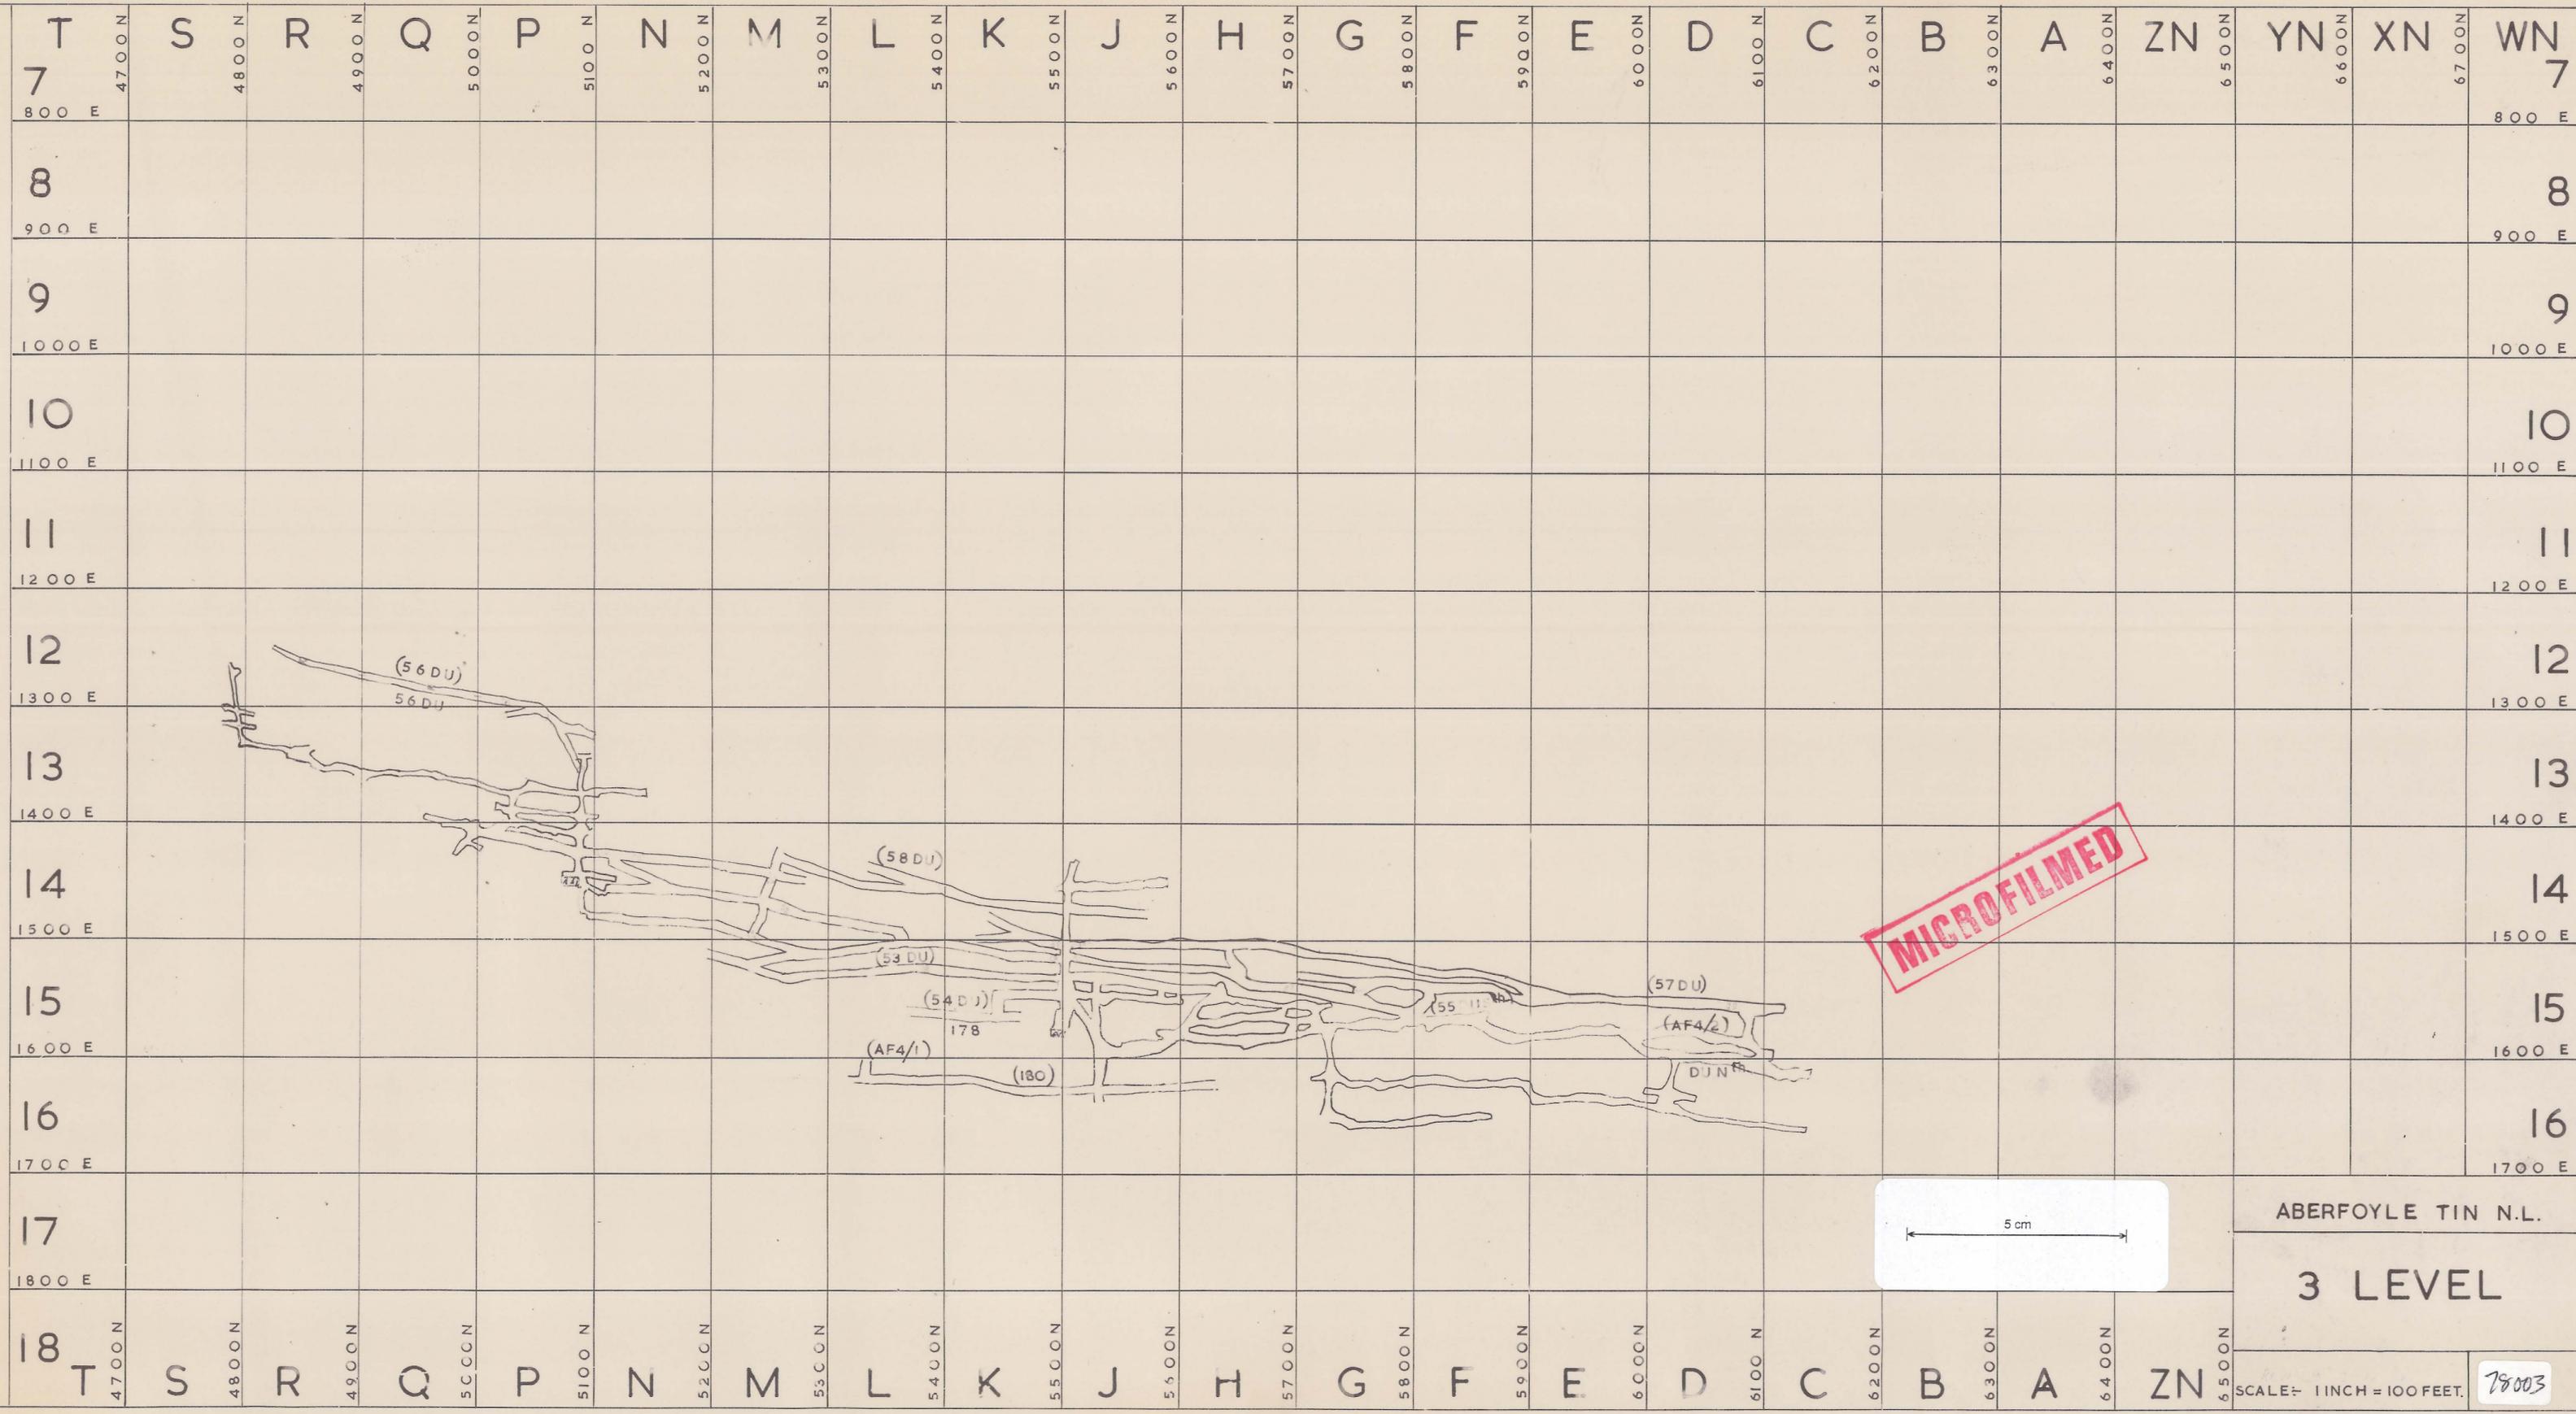

MICROFILMED

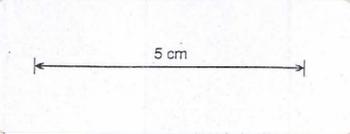

ABERFOYLE TIN N.L.
3 LEVEL

SCALE: 1 INCH = 100 FEET. 78003