



ABERF_779

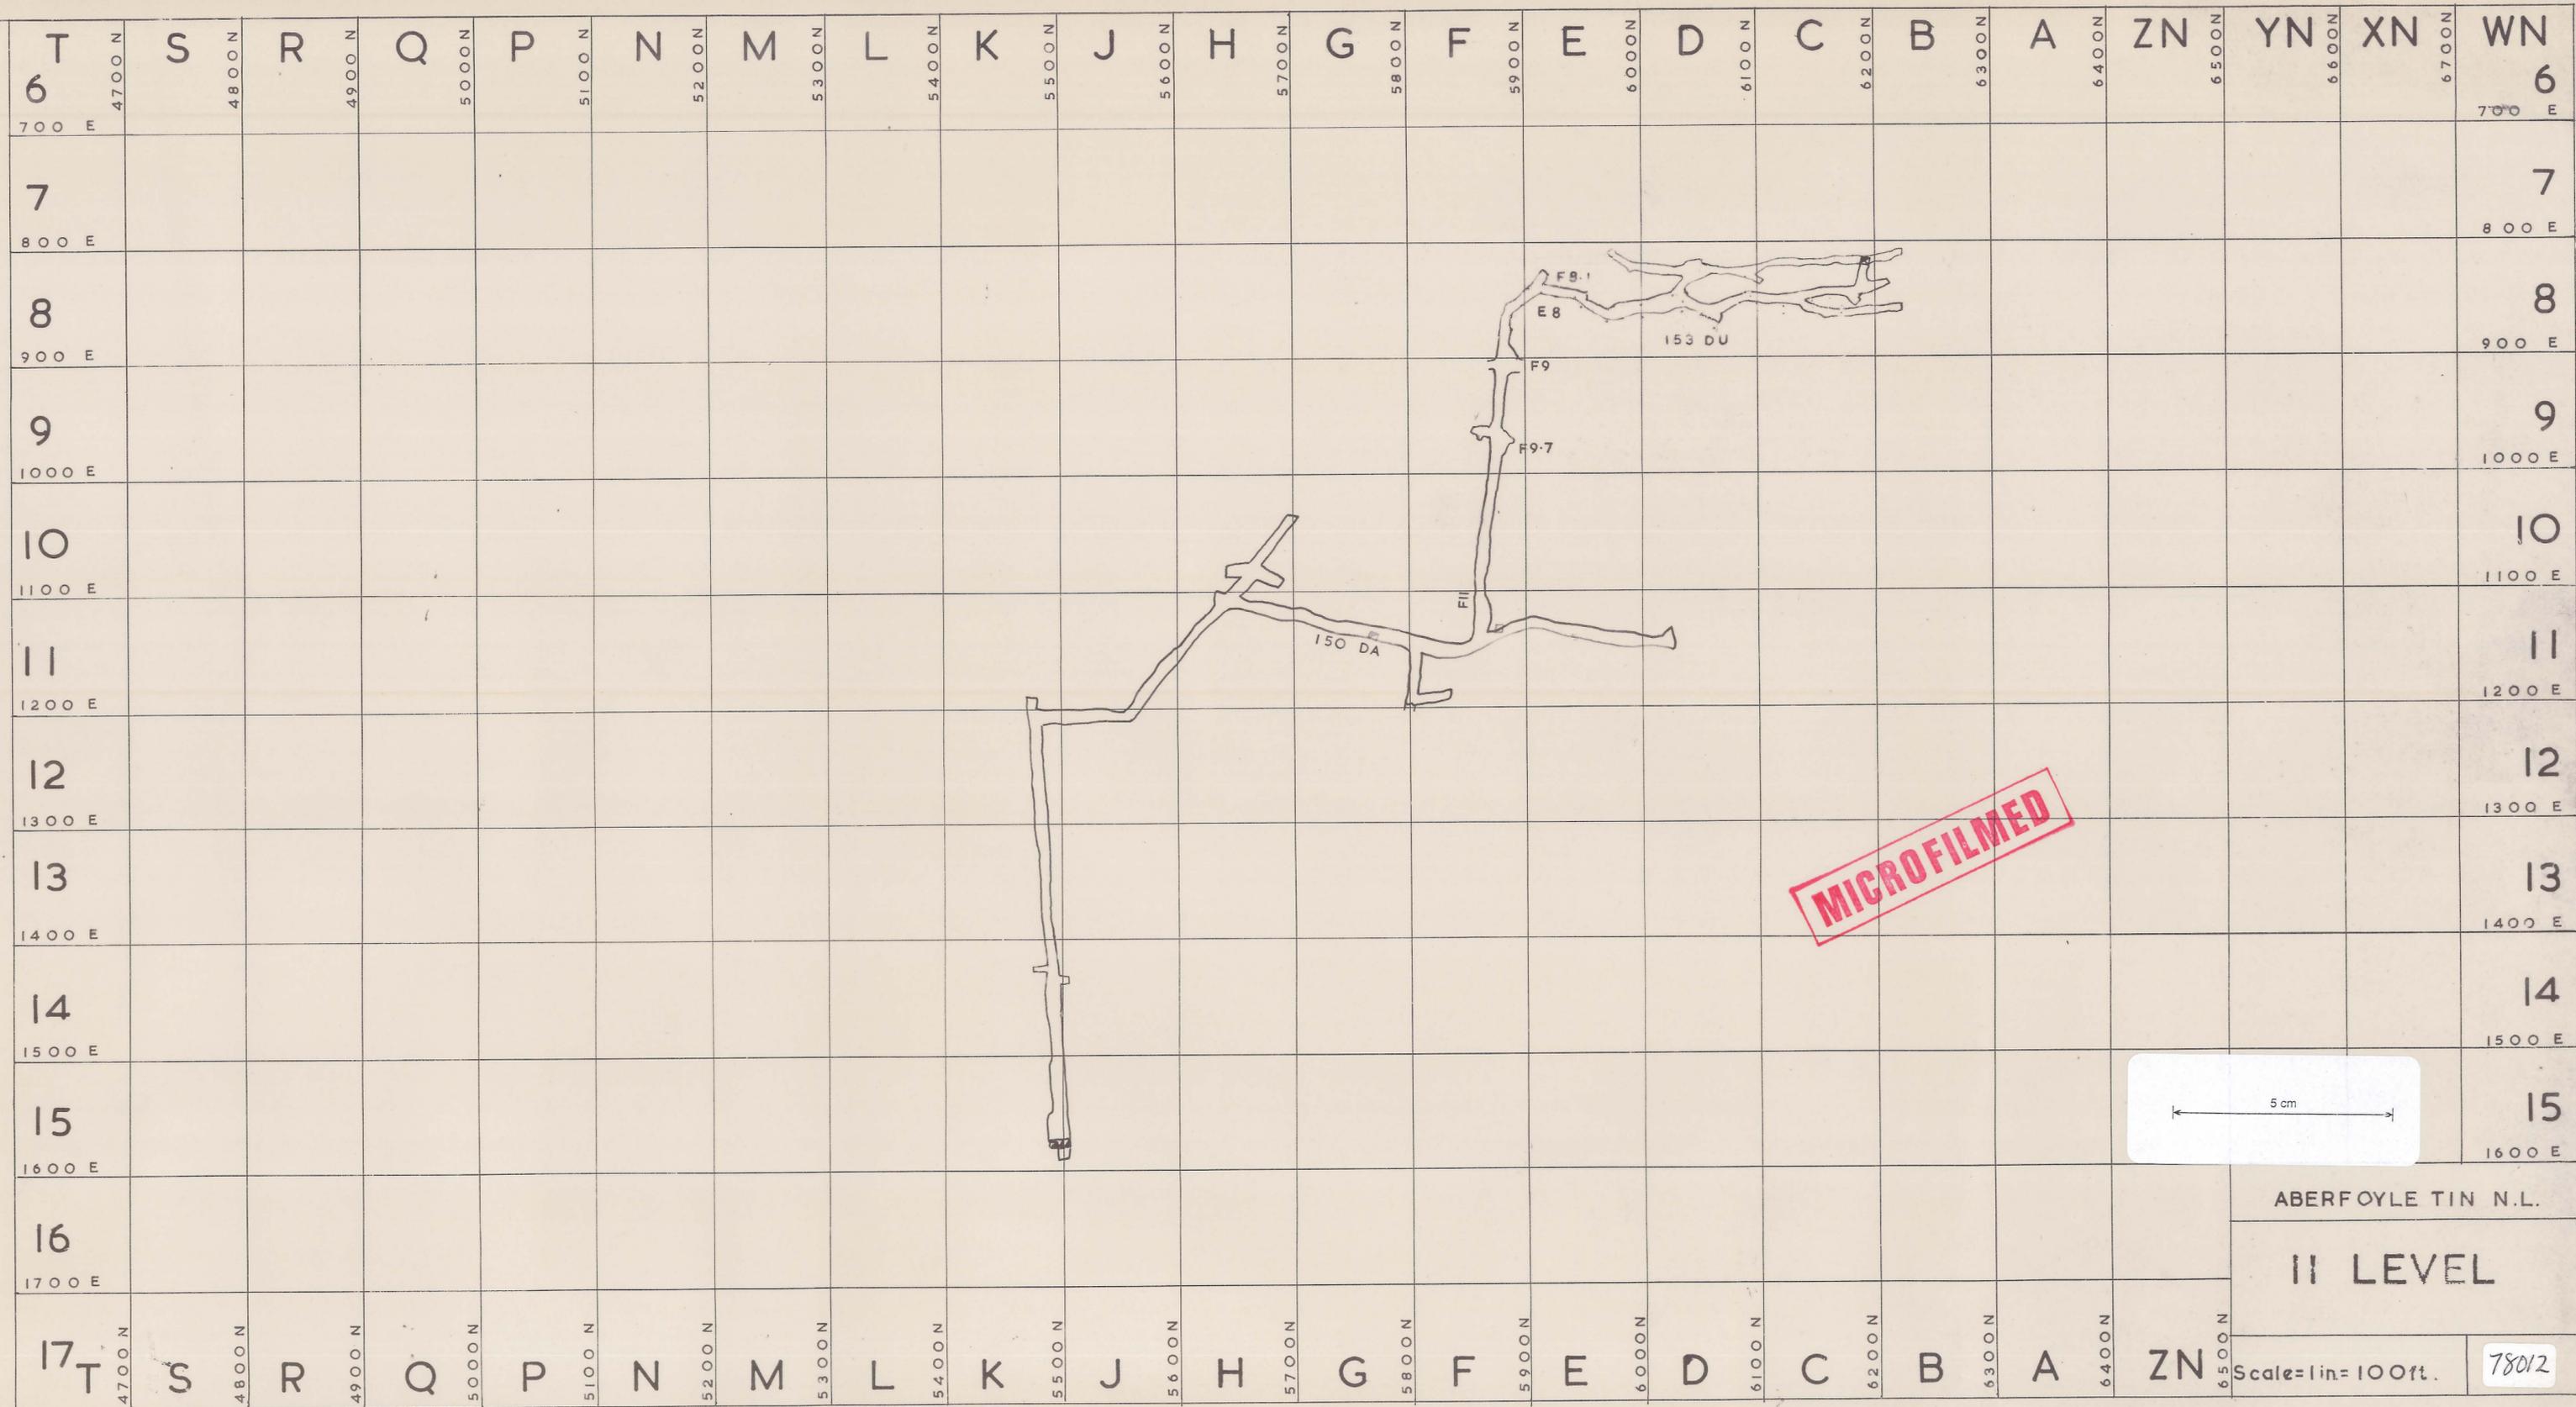

MICROFILMED

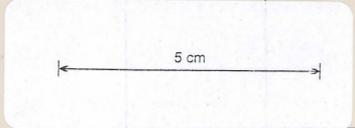

ABERFOYLE TIN N.L.

II LEVEL

Scale = 1 in = 100 ft.

78012