ABERF_783

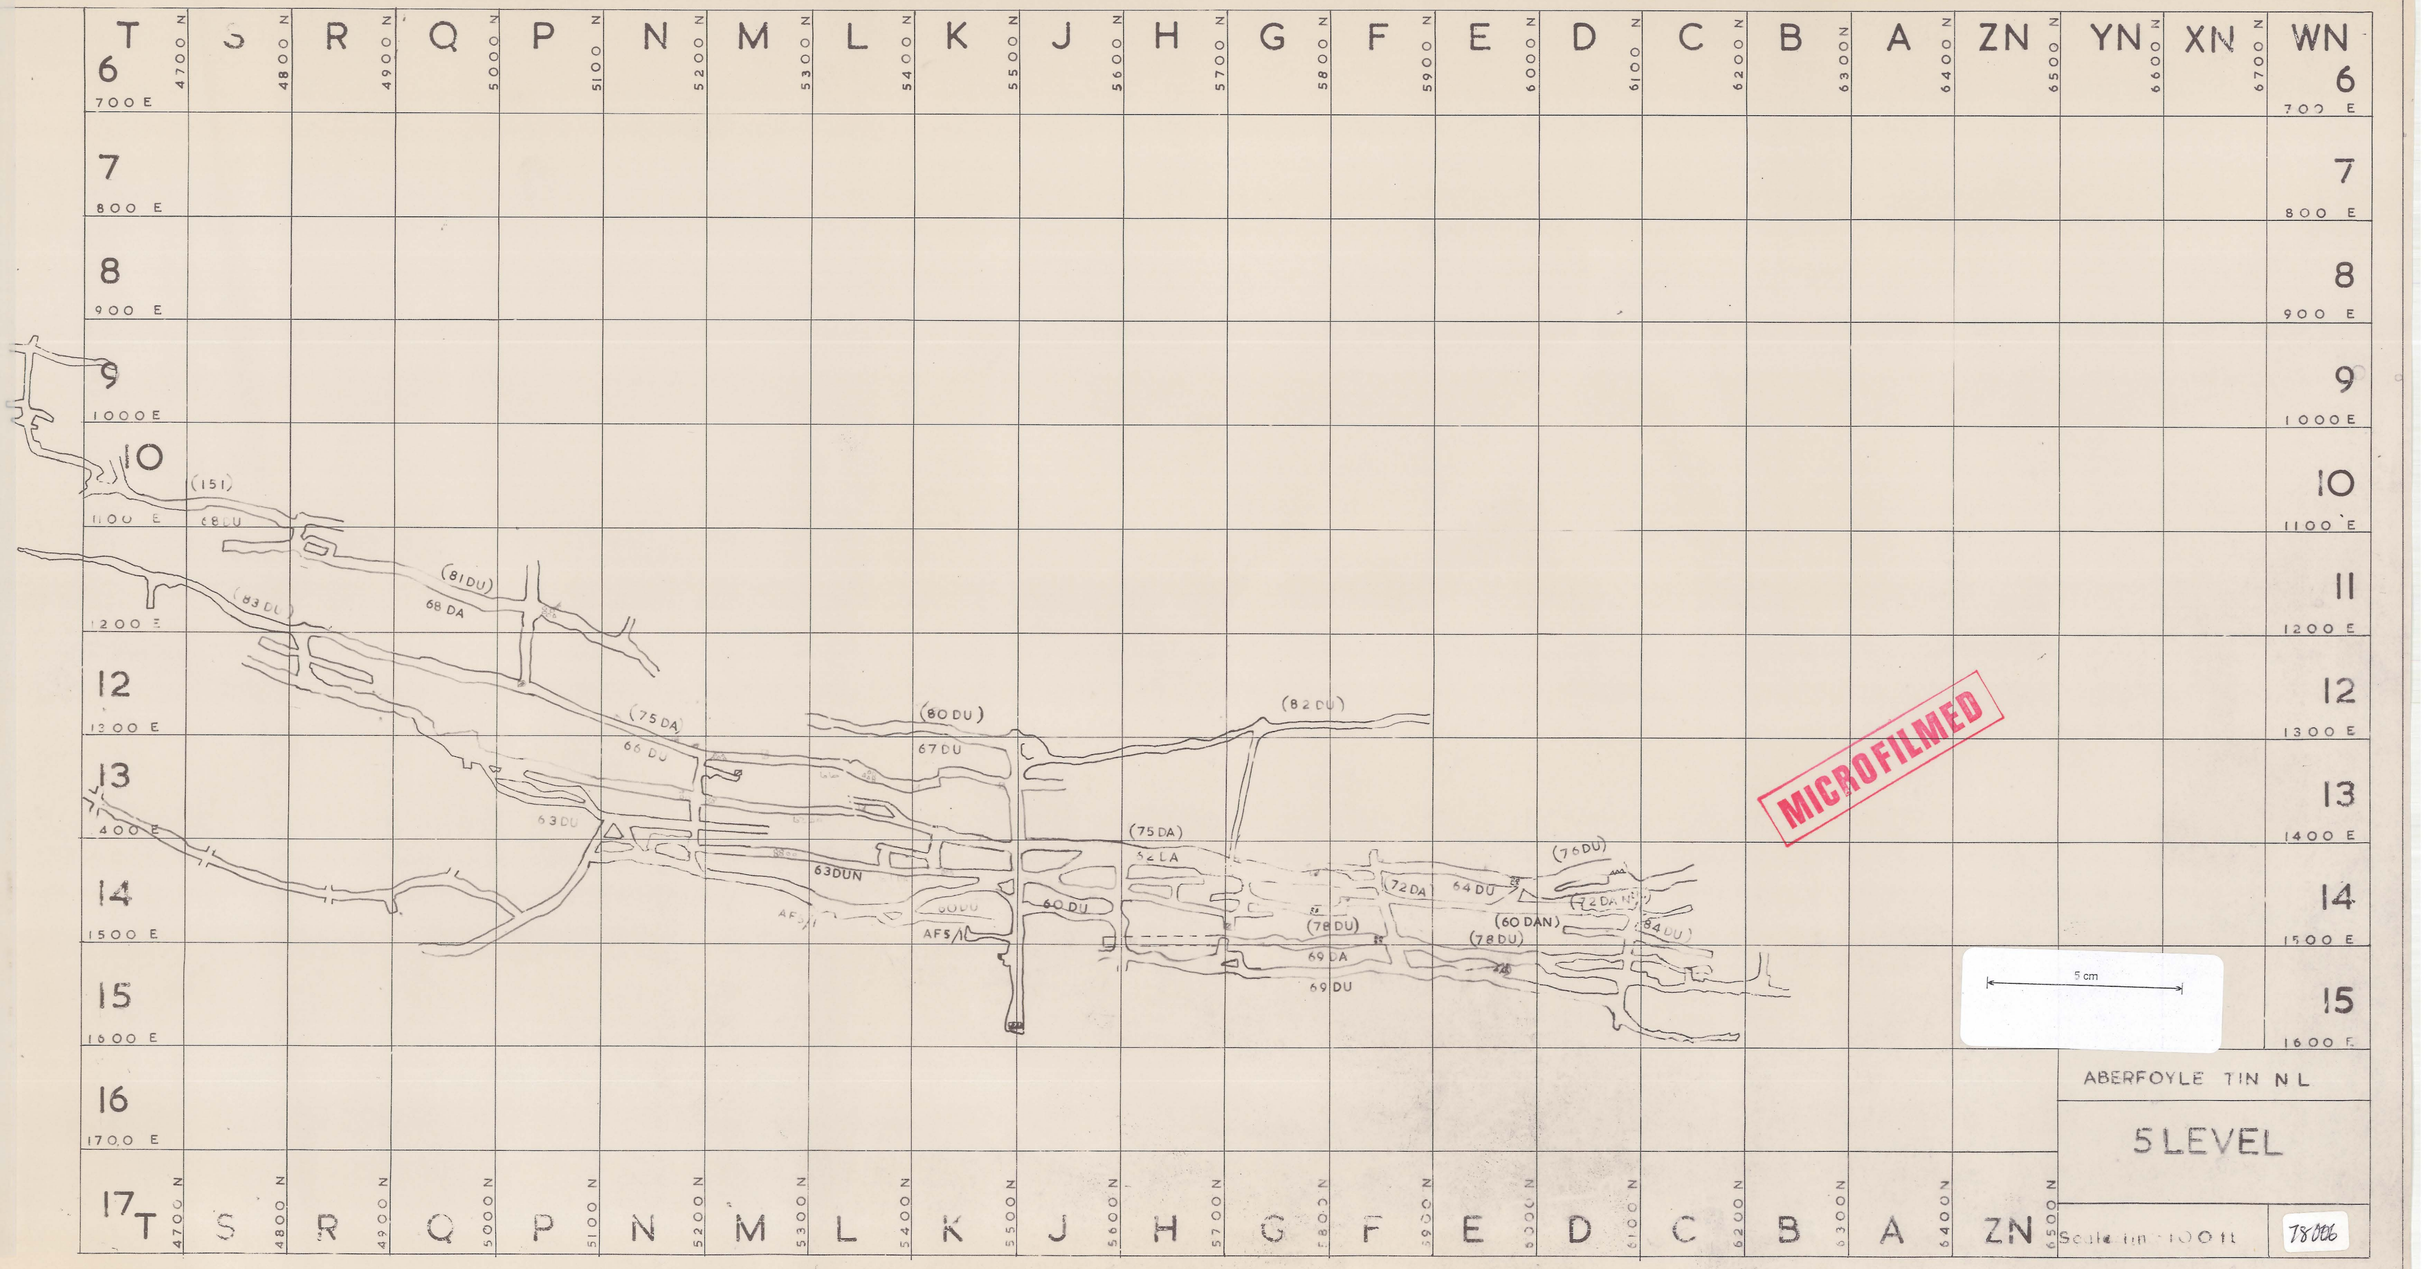
T S R Q P N M L K J H G F E D C B A ZN YN XN WN
4700 N 4800 N 4900 N 5000 N 5100 N 5200 N 5300 N 5400 N 5500 N 5600 N 5700 N 5800 N 5900 N 6000 N 6100 N 6200 N 6300 N 6400 N 6500 N 6600 N 6700 N
6 700 E
7 800 E
8 900 E
9 1000 E
10 1100 E
11 1200 E
12 1300 E
13 1400 E
14 1500 E
15 1600 E
16 1700 E
17
(151)
68DU
(81DU)
68 DA
(83 DU)
(75 DA)
68 DU
63 DU
63DUN
(80 DU)
67 DU
60 DU
AF5
(75 DA)
52 LA
(82 DU)
72 DA
64 DU
(76 DU)
(60 DAN)
(78 DU)
69 DA
69 DU
MICROFILMED
5 cm
ABERFOYLE TIN N L
5 LEVEL
Scale 1in = 100 ft
78006