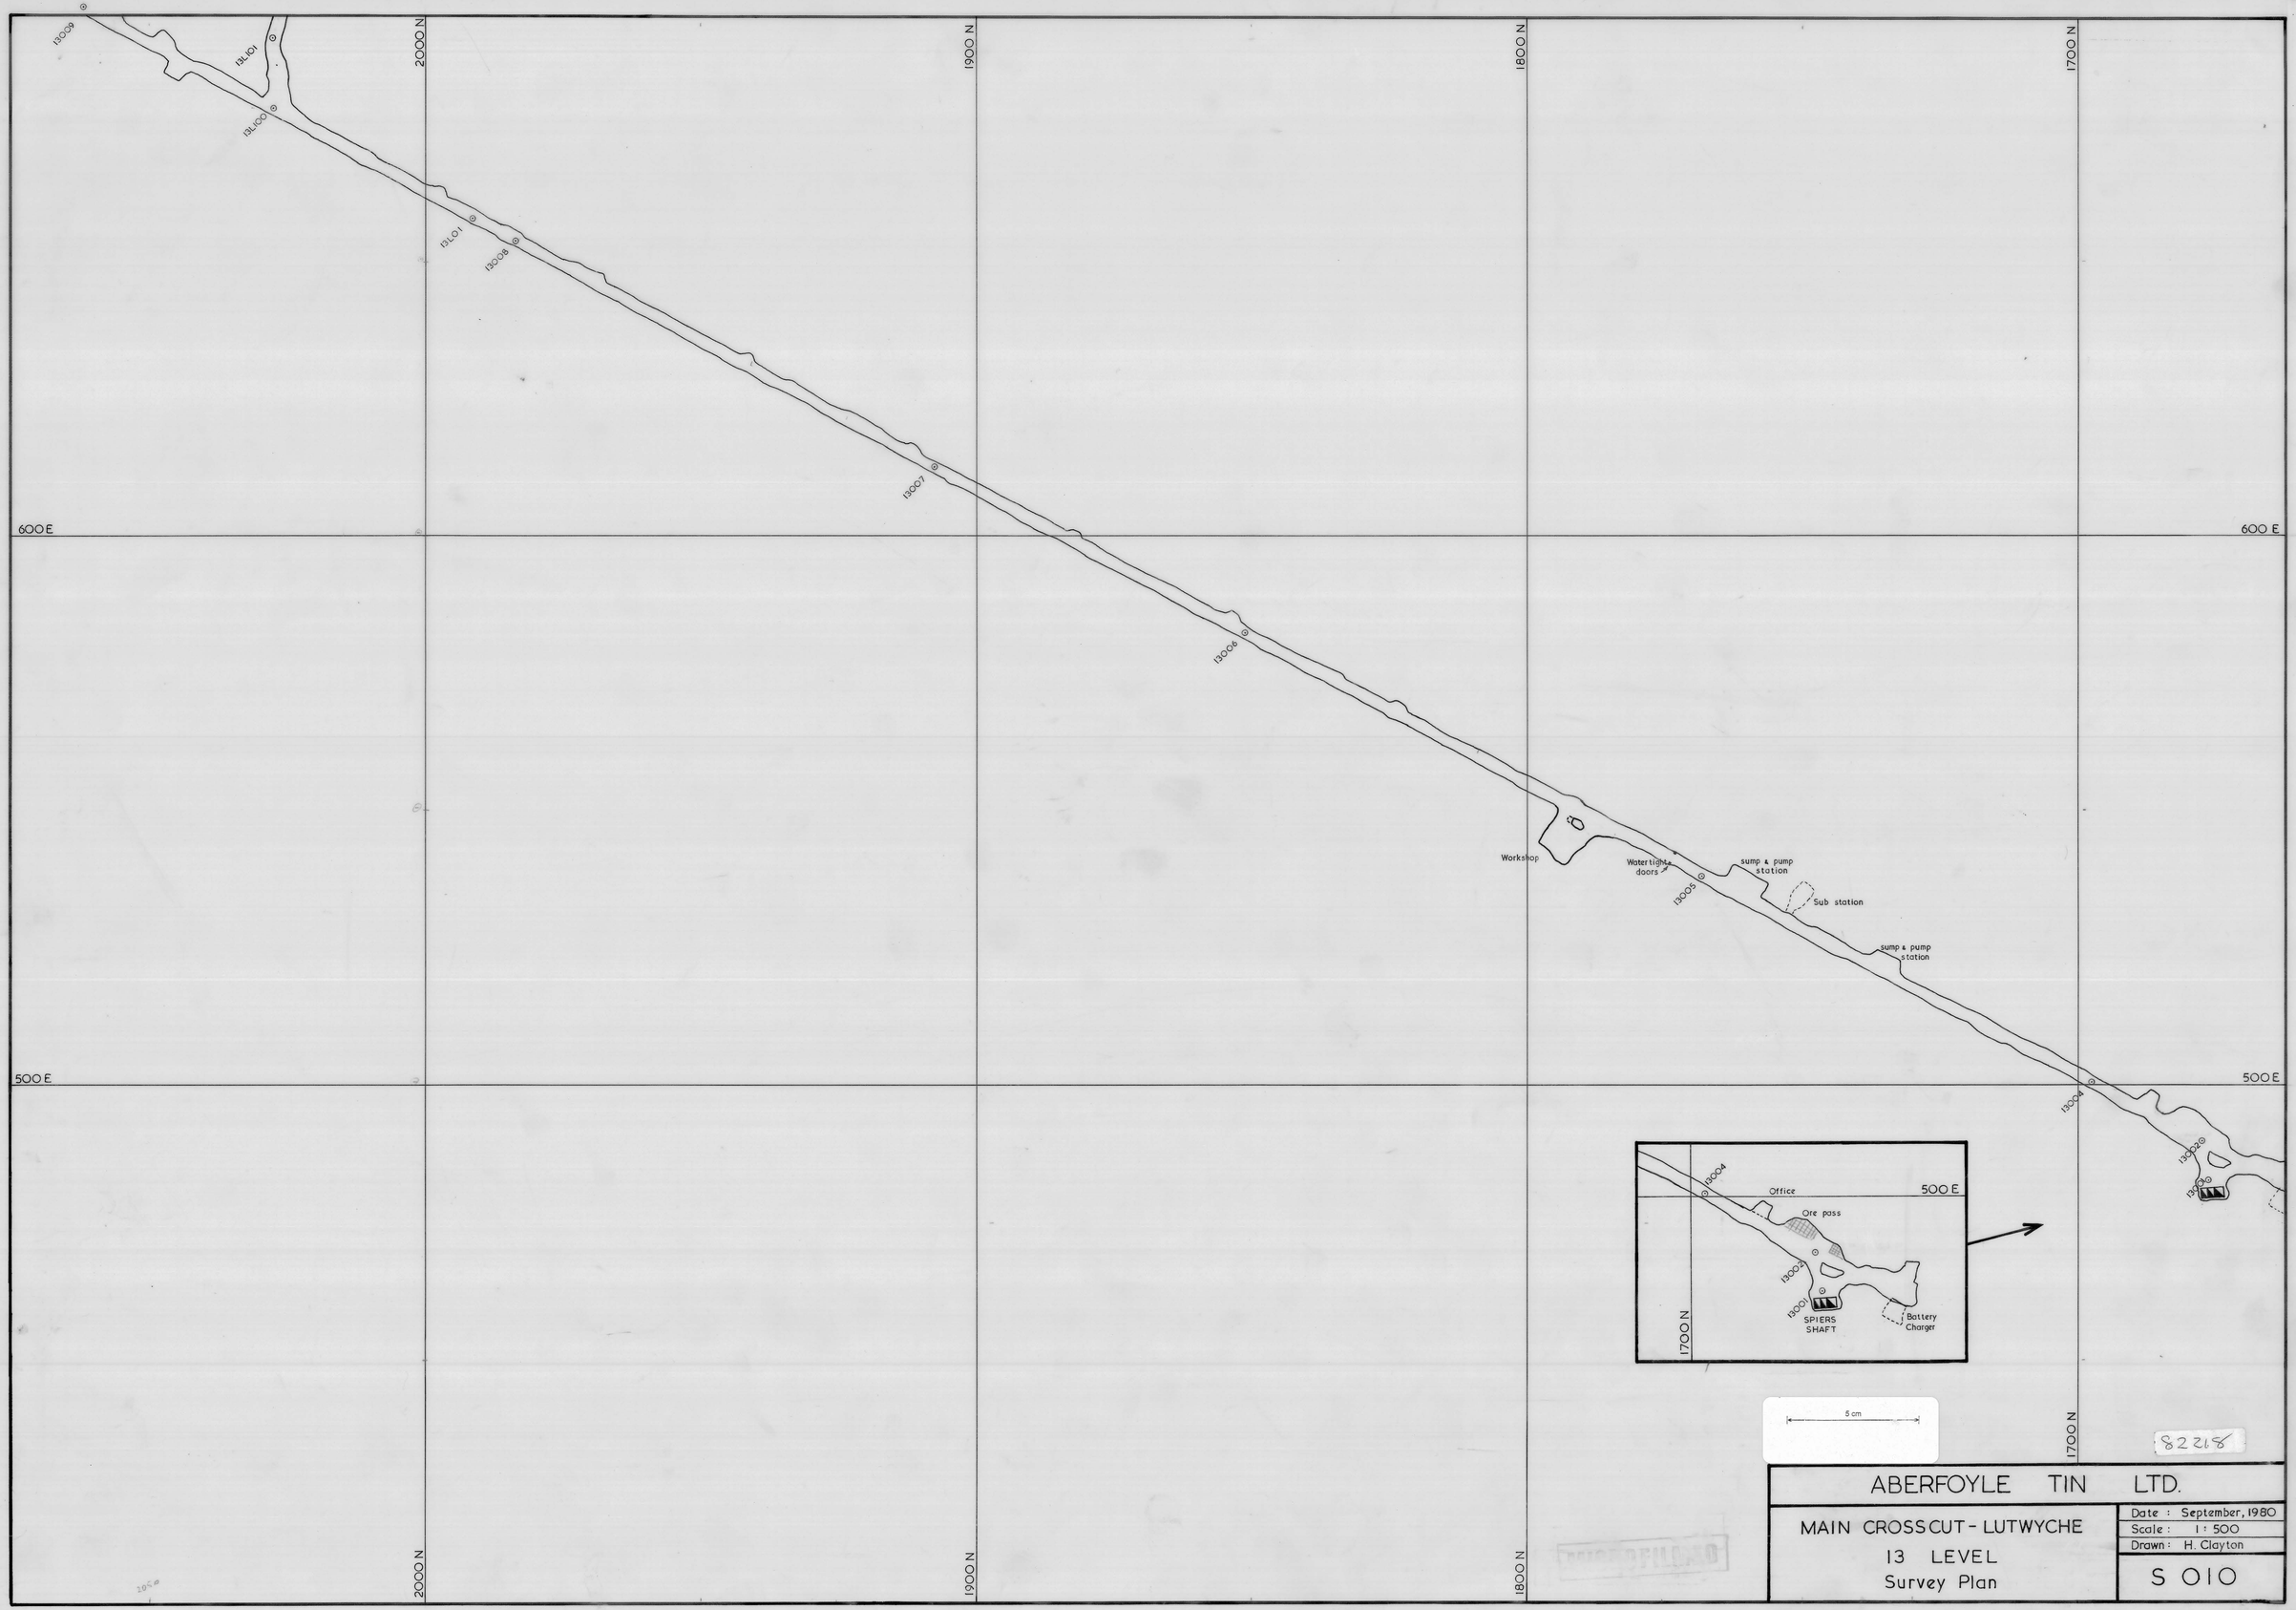
2000 N
1900 N
1800 N
1700 N
600 E
500 E
13009
13L01
13L00
13L01
13008
13007
13006
Workshop
Water tight doors
13005
sump & pump station
Sub station
sump & pump station
13004
13003
Office
Ore pass
13002
13001
SPIERS SHAFT
Battery Charger
5 cm
82218
ABERFOYLE TIN LTD.
MAIN CROSSCUT - LUTWYCHE
13 LEVEL
Survey Plan
Date : September, 1980
Scale : 1 : 500
Drawn : H. Clayton
S 010

ABERF_784