


220
160
120
100

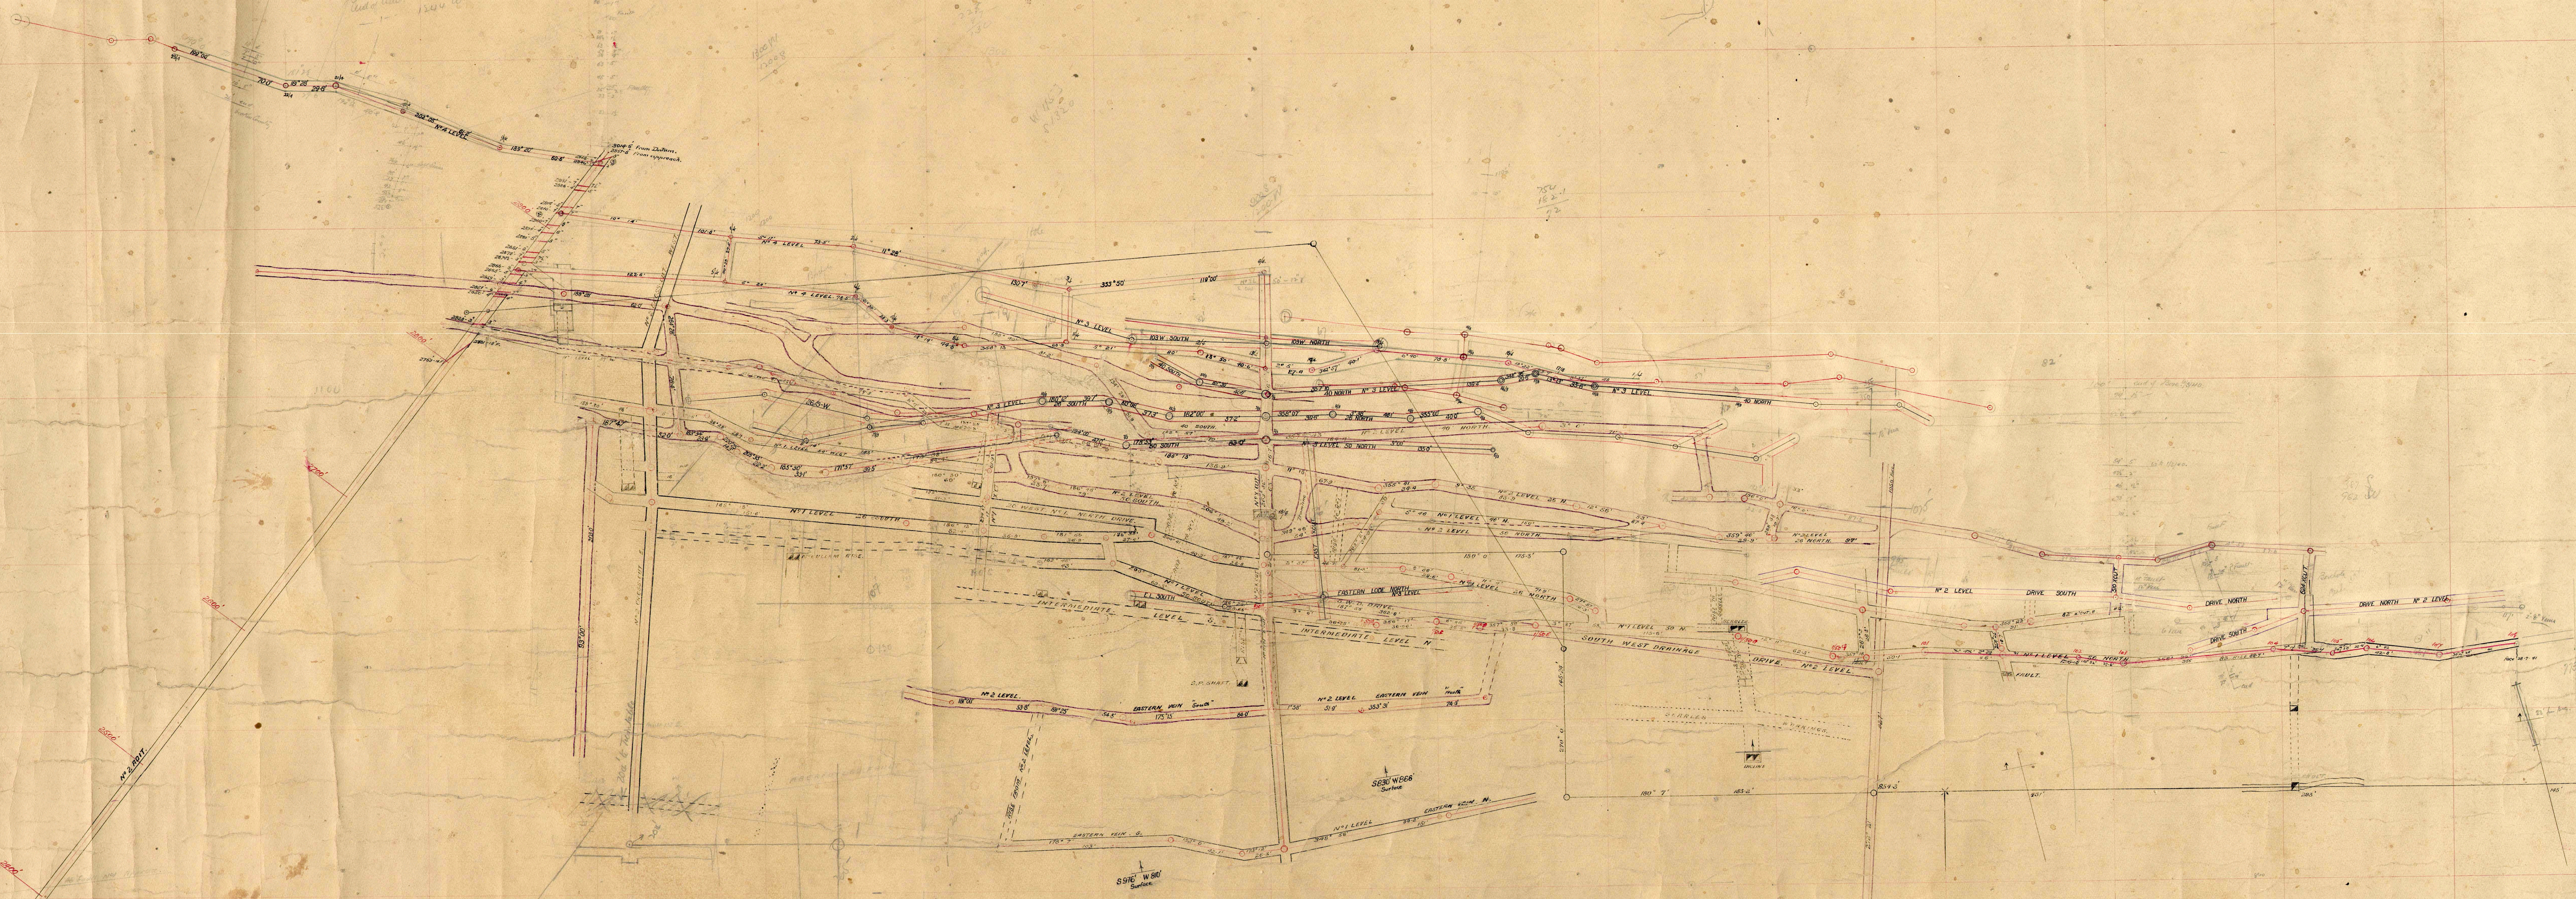

M

L

K

J

H

A

19

18

17

16

15

14

13

12

11

10

9

8

7

6

5

4

3

2

1

100