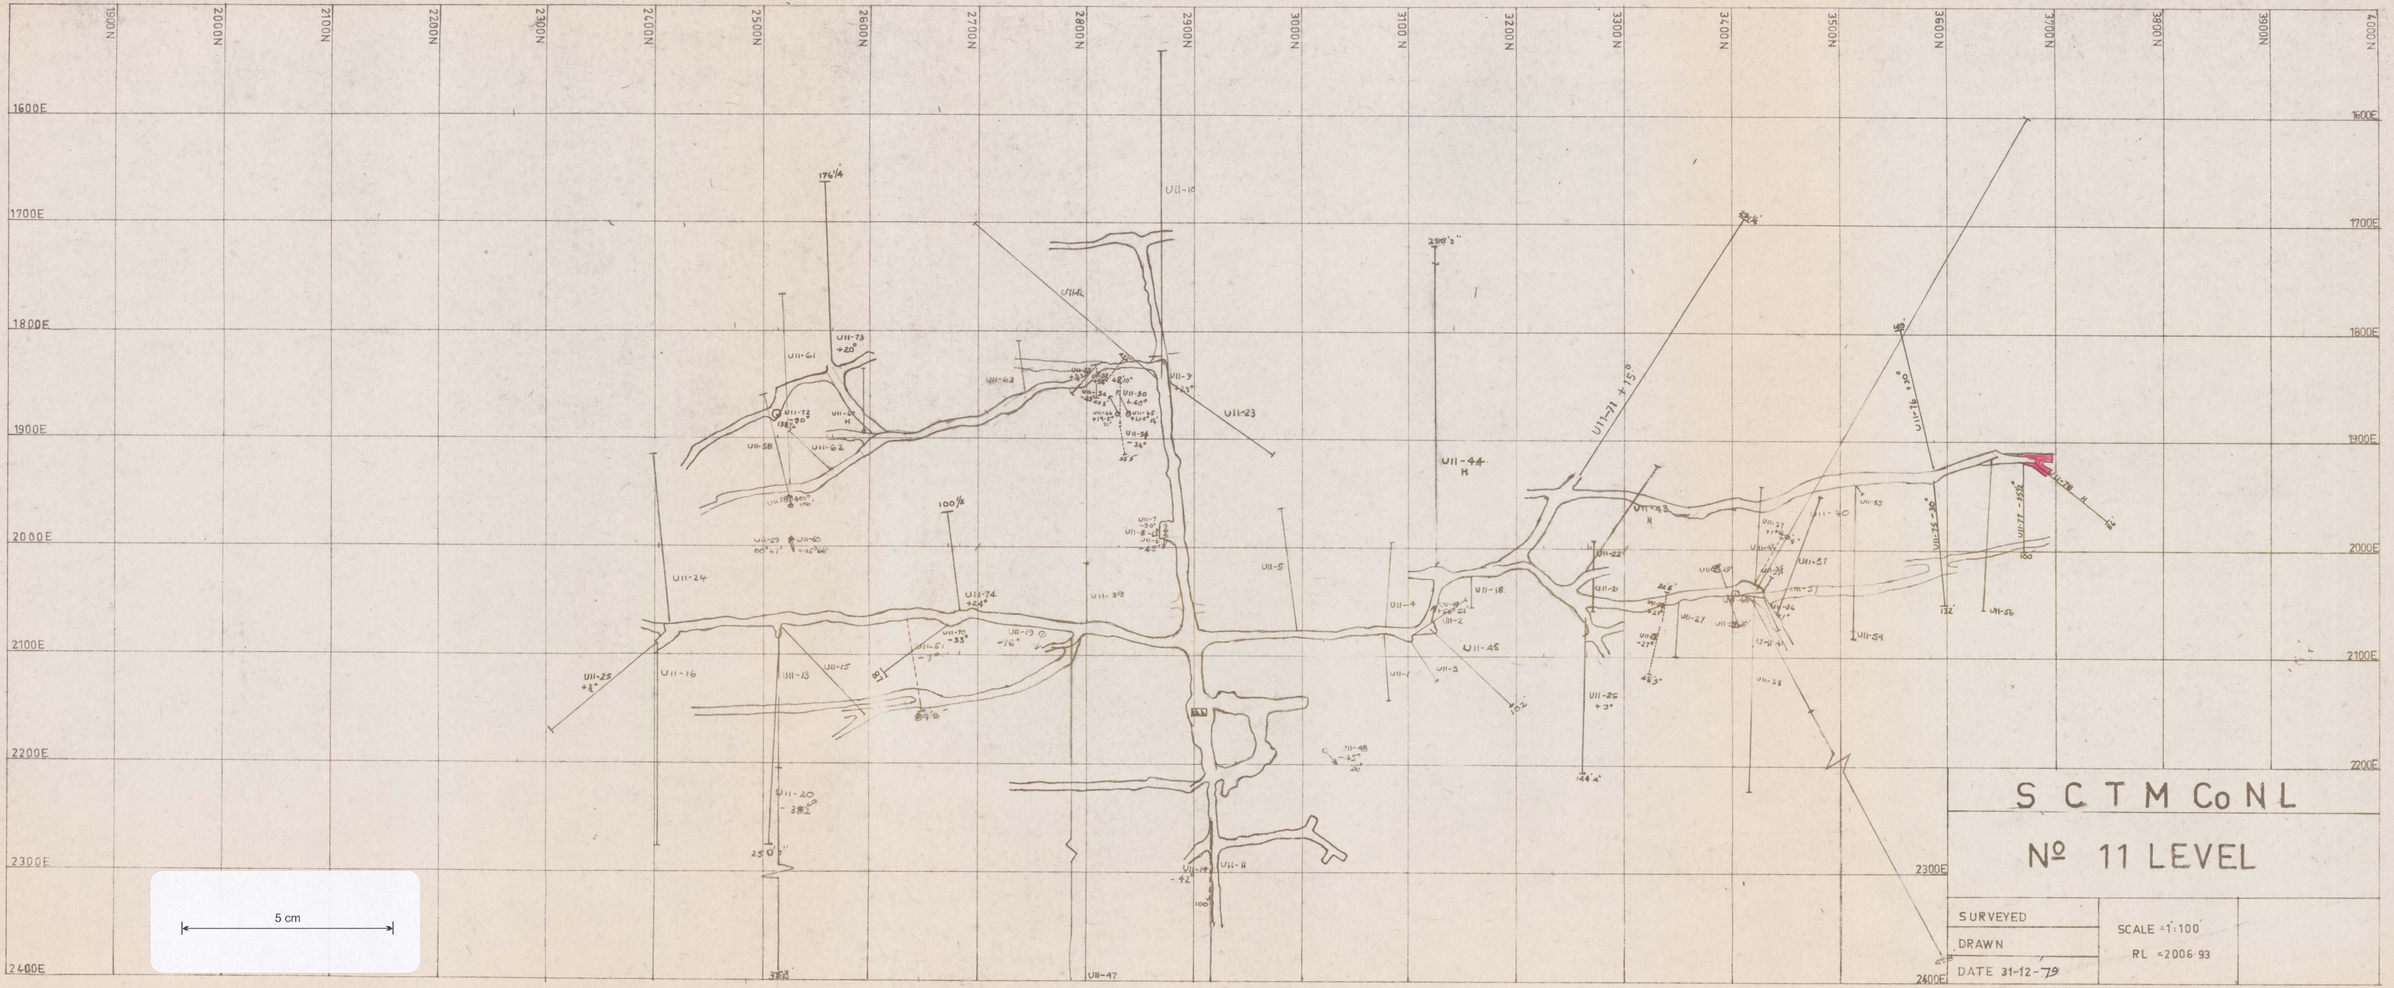
1900N
2000N
2100N
2200N
2300N
2400N
2500N
2600N
2700N
2800N
2900N
3000N
3100N
3200N
3300N
3400N
3500N
3600N
3700N
3800N
3900N
4000N
1600E
1700E
1800E
1900E
2000E
2100E
2200E
2300E
2400E
U11-44
U11-45
U11-71 +15°
U11-74 +24°
U11-73 +20°
U11-20 -38°
U11-25 +3°
U11-24
U11-16
U11-15
U11-13
U11-5
U11-4
U11-18
U11-2
U11-3
U11-1
U11-23
U11-39
U11-47
U11-48
U11-51
U11-54
U11-55
U11-56
U11-57
U11-58
U11-61
U11-62
U11-63
U11-27
U11-28
U11-30
U11-34
U11-36
U11-40
U11-43
U11-46
U11-49
U11-50
U11-52
U11-53
U11-59
U11-60
U11-70 -33°
U11-72 -30°
U11-76 +30°
U11-77 -35°
U11-78 H
U11-14
U11-11
U11-10
U11-9
U11-7
U11-8
U11-19
U11-21
U11-22
U11-26
U11-38
U11-35
U11-37
U11-33
U11-32
U11-31
U11-29
U11-6
U11-12
U11-17
U11-42
U11-46
176'4"
100'4"
25'0"
29'8"
124'4"
132
180
5 cm
S C T M Co N L
Nº 11 LEVEL
SURVEYED
DRAWN
DATE 31-12-79
SCALE = 1:100
RL = 2006·93

ABERF-827