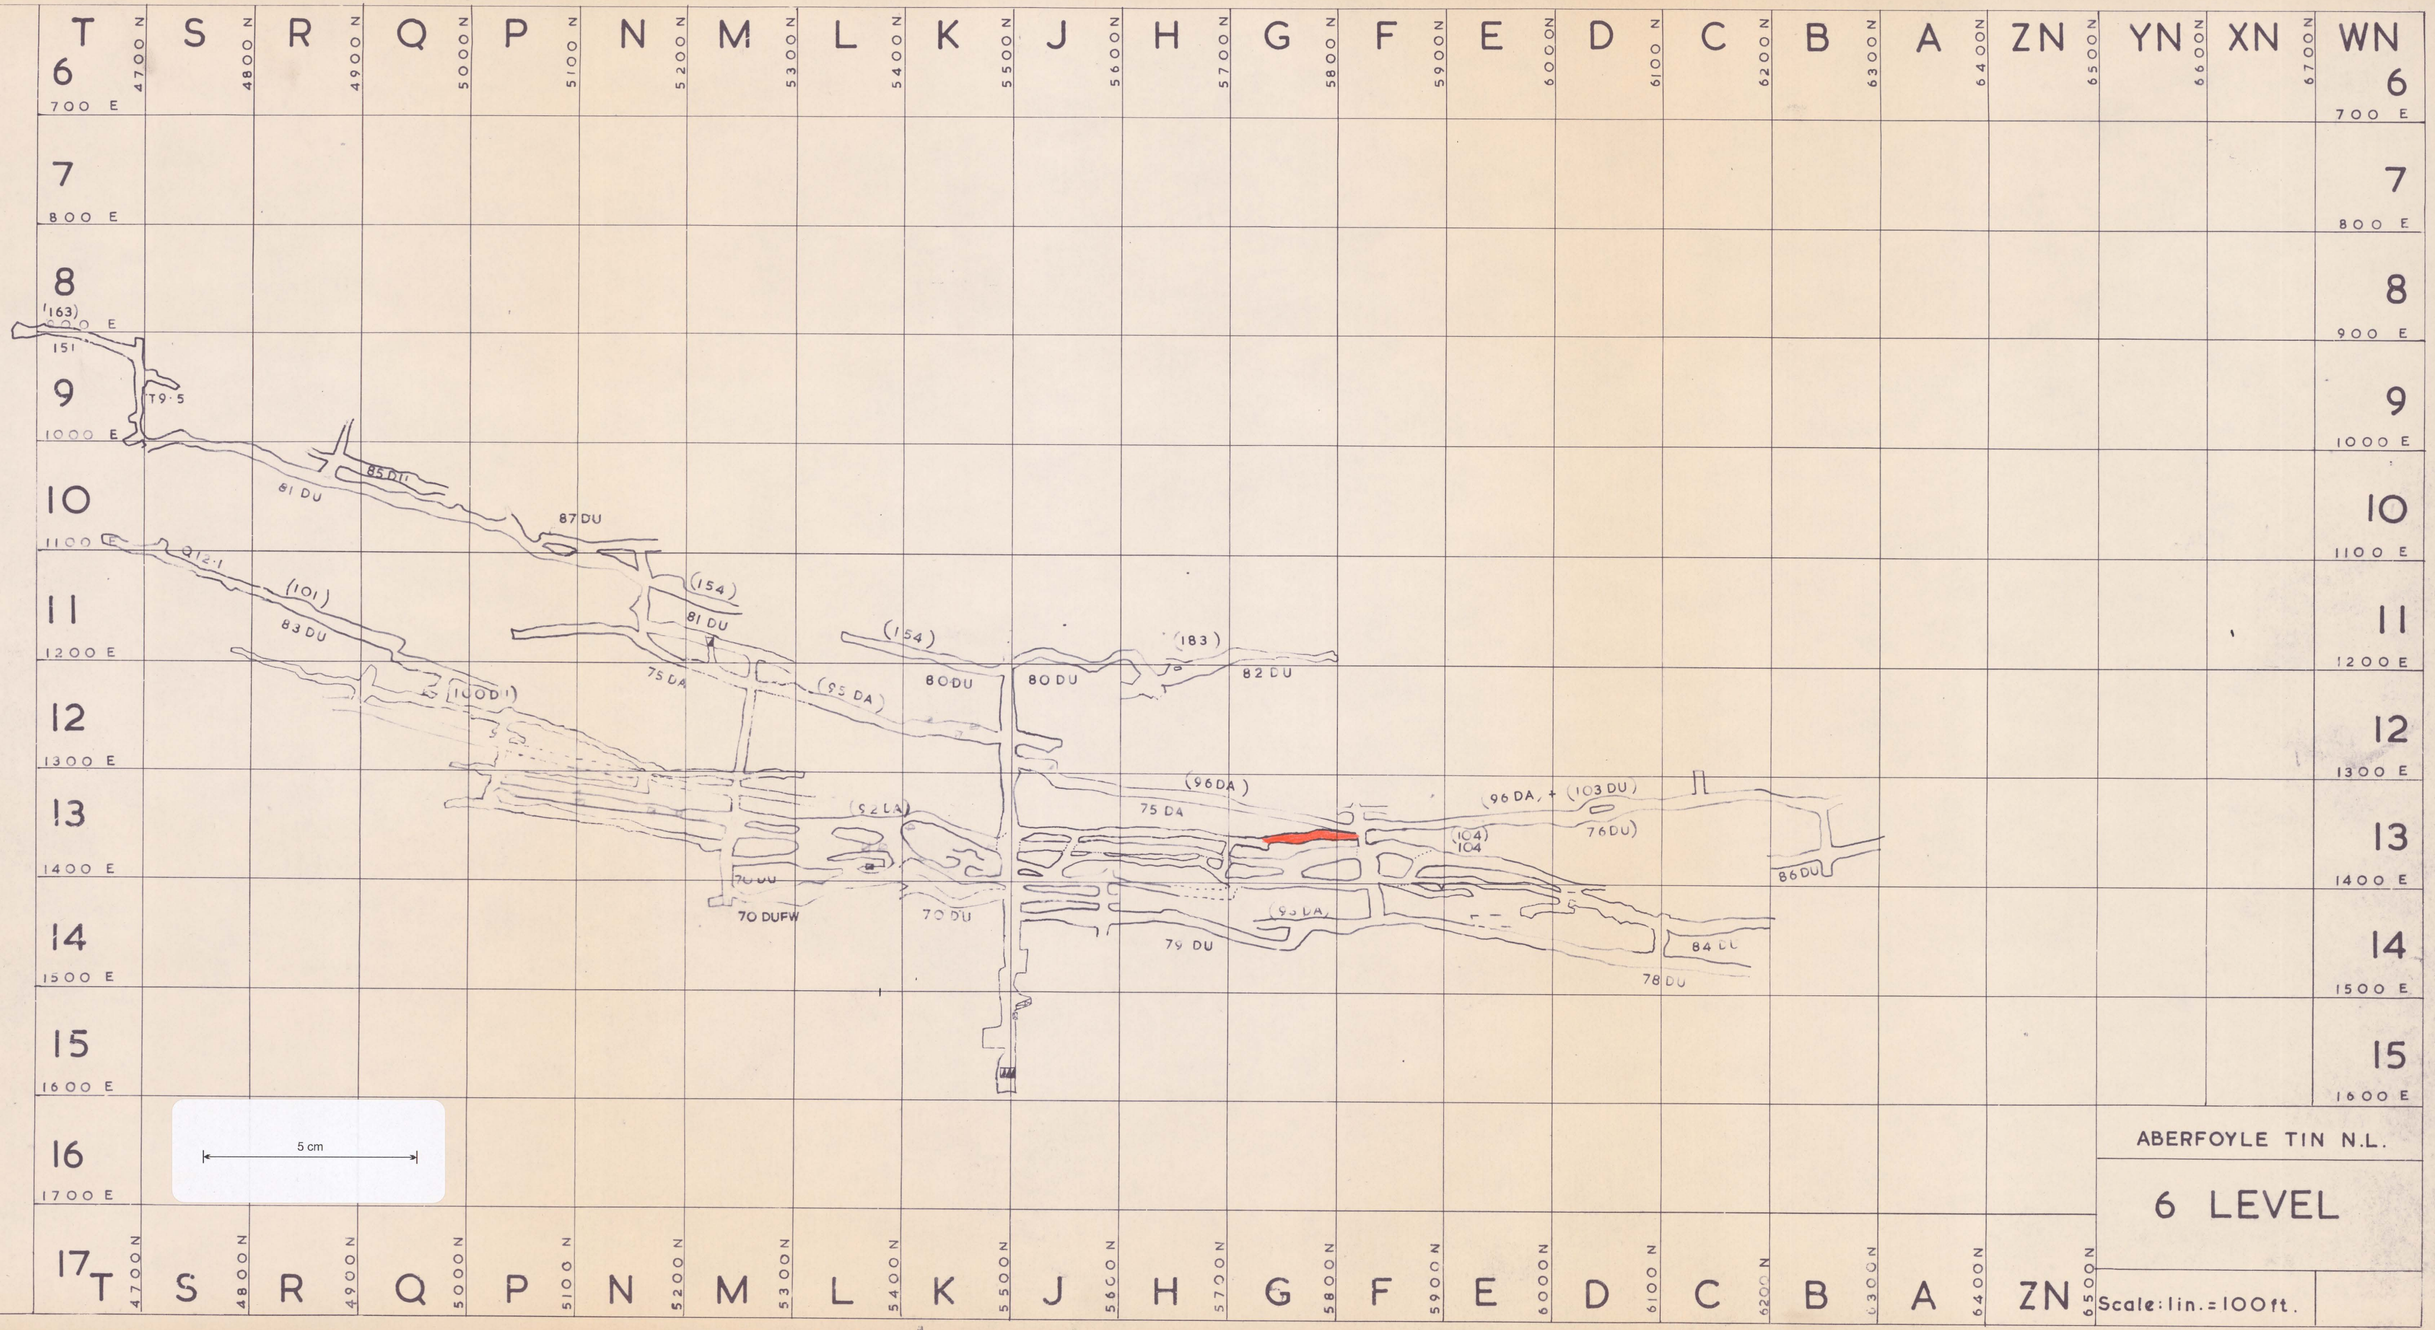
T S R Q P N M L K J H G F E D C B A ZN YN XN WN
4700 N 4800 N 4900 N 5000 N 5100 N 5200 N 5300 N 5400 N 5500 N 5600 N 5700 N 5800 N 5900 N 6000 N 6100 N 6200 N 6300 N 6400 N 6500 N 6600 N 6700 N
6 700 E
7 800 E
8 900 E
9 1000 E
10 1100 E
11 1200 E
12 1300 E
13 1400 E
14 1500 E
15 1600 E
16 1700 E
17
(163)
151
T9·5
85 DU
81 DU
87 DU
(154)
81 DU
75 DA
(95 DA)
(154)
80 DU
80 DU
(183)
82 DU
(96 DA)
75 DA
96 DA, + (103 DU)
76 DU)
(104)
104
86 DU
(92 LA)
70 DU
70 DUFW
70 DU
(95 LA)
79 DU
84 DU
78 DU
(101)
83 DU
(100 DU)
5 cm
ABERFOYLE TIN N.L.
6 LEVEL
Scale: 1in. = 100ft.

ABERF – 835