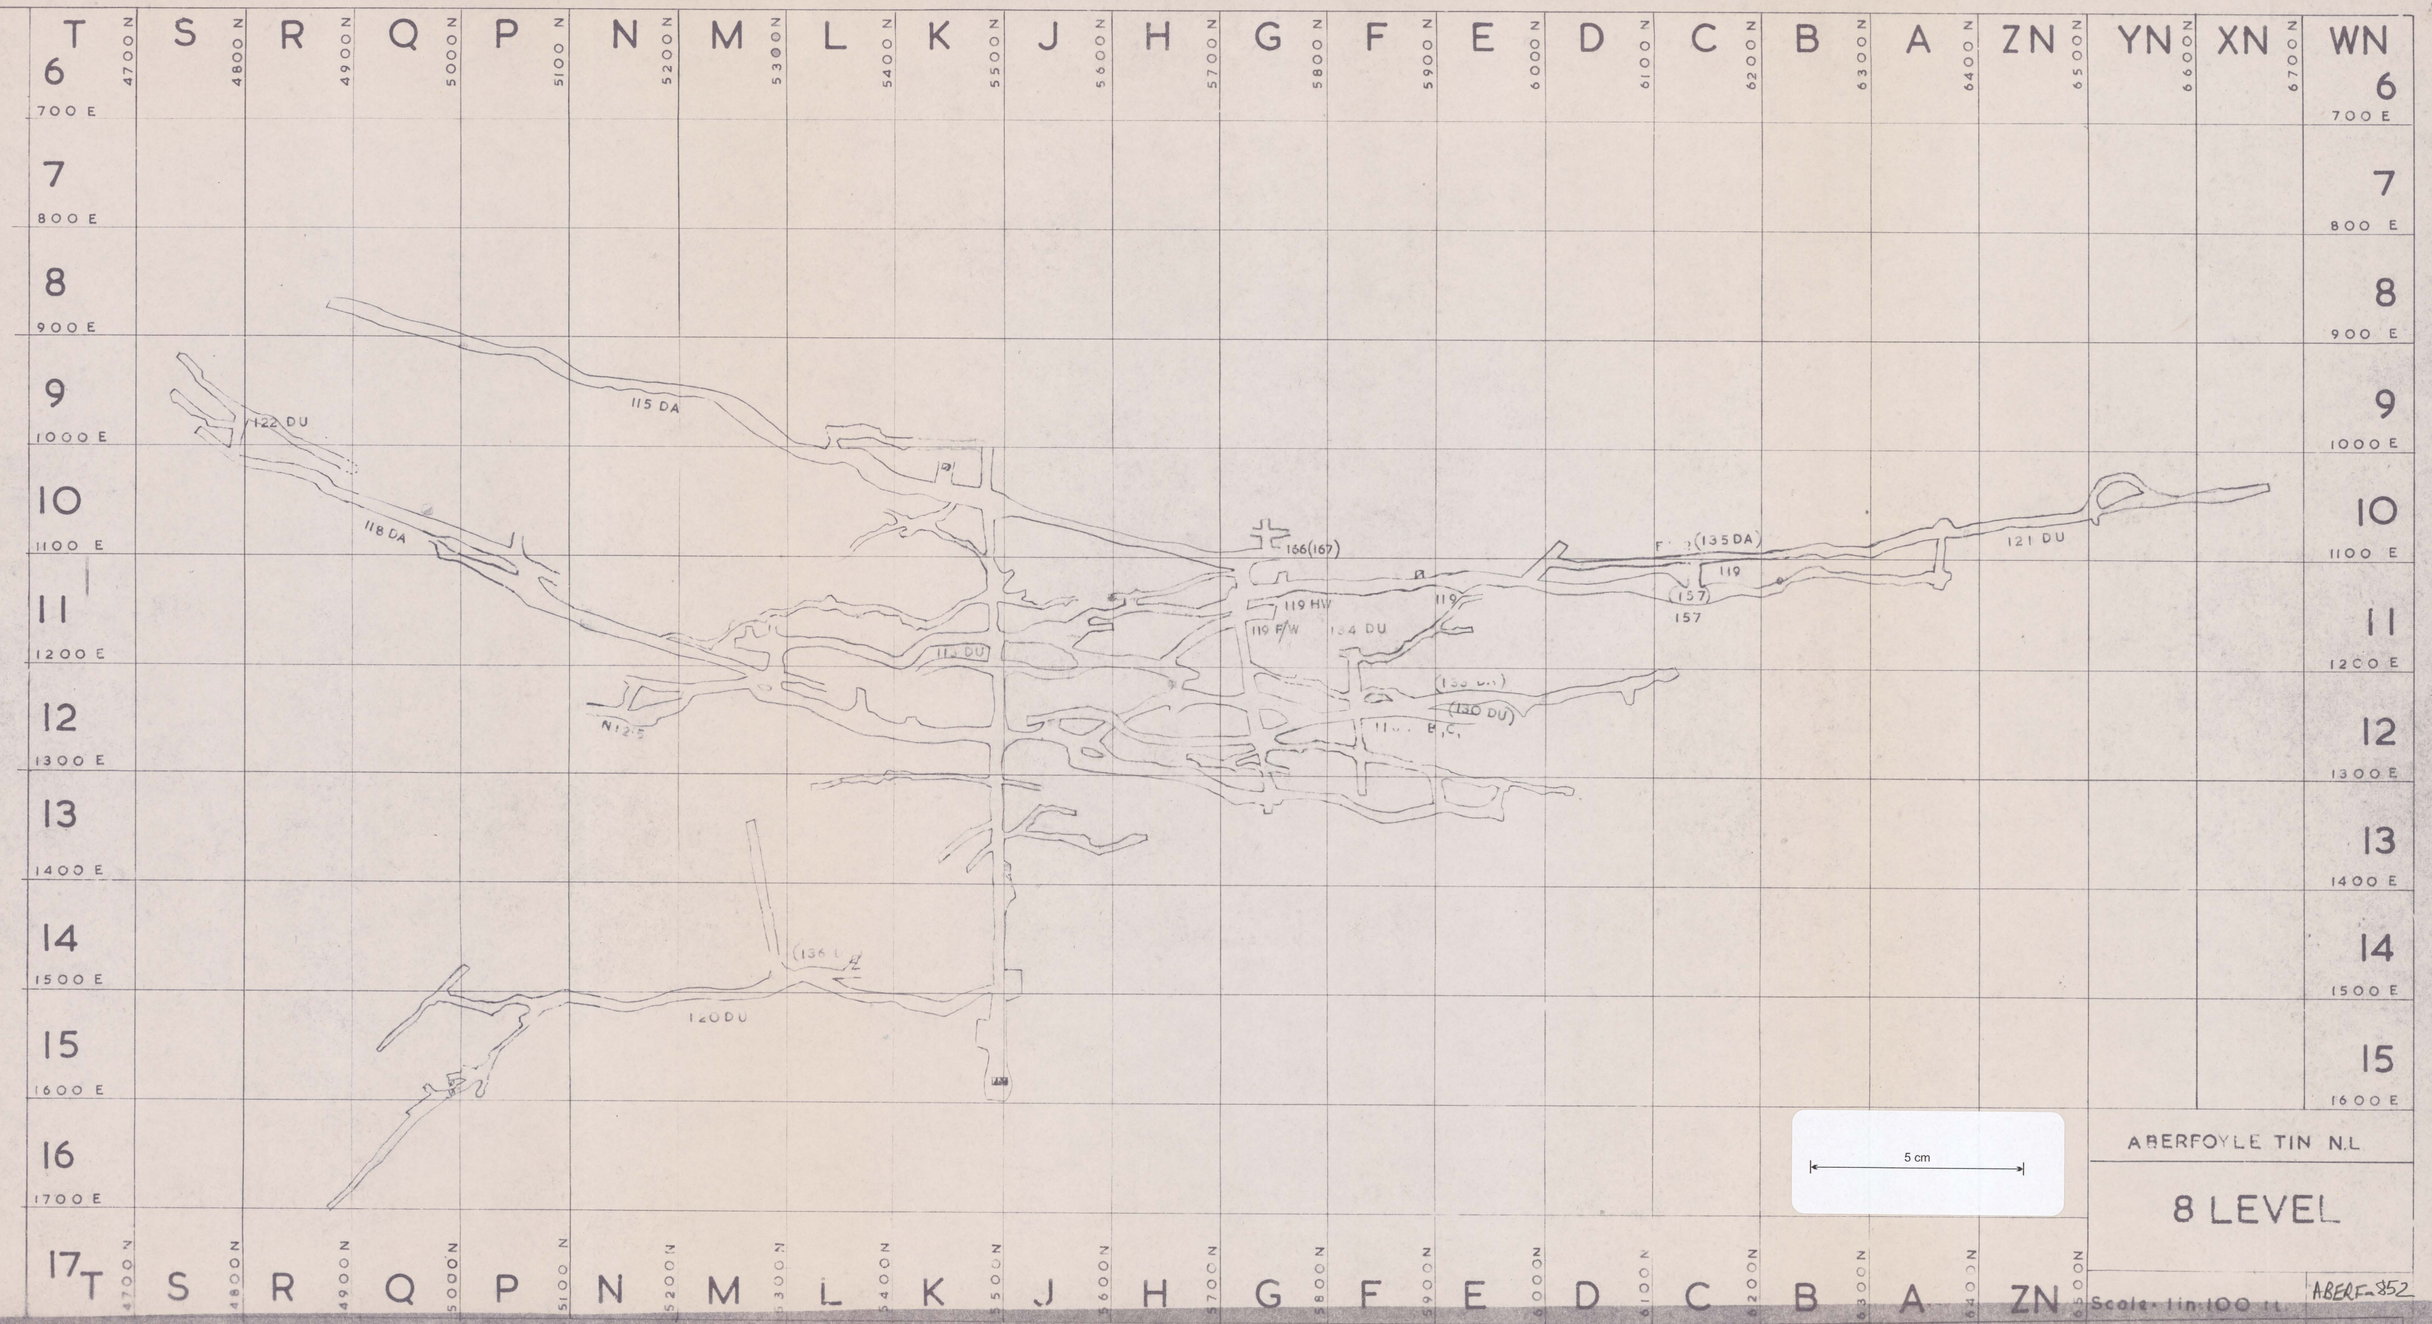
T S R Q P N M L K J H G F E D C B A ZN YN XN WN
4700 N 4800 N 4900 N 5000 N 5100 N 5200 N 5300 N 5400 N 5500 N 5600 N 5700 N 5800 N 5900 N 6000 N 6100 N 6200 N 6300 N 6400 N 6500 N 6600 N 6700 N
6 700 E
7 800 E
8 900 E
9 1000 E
10 1100 E
11 1200 E
12 1300 E
13 1400 E
14 1500 E
15 1600 E
16 1700 E
17
122 DU
115 DA
118 DA
N125
120 DU
(136 L)
166(167)
119 HW
119 F/W
134 DU
(130 DU)
(135 DA)
119
(157)
157
121 DU
5 cm
ABERFOYLE TIN N.L.
8 LEVEL
Scale: 1 in. 100 ft.
ABERF-352