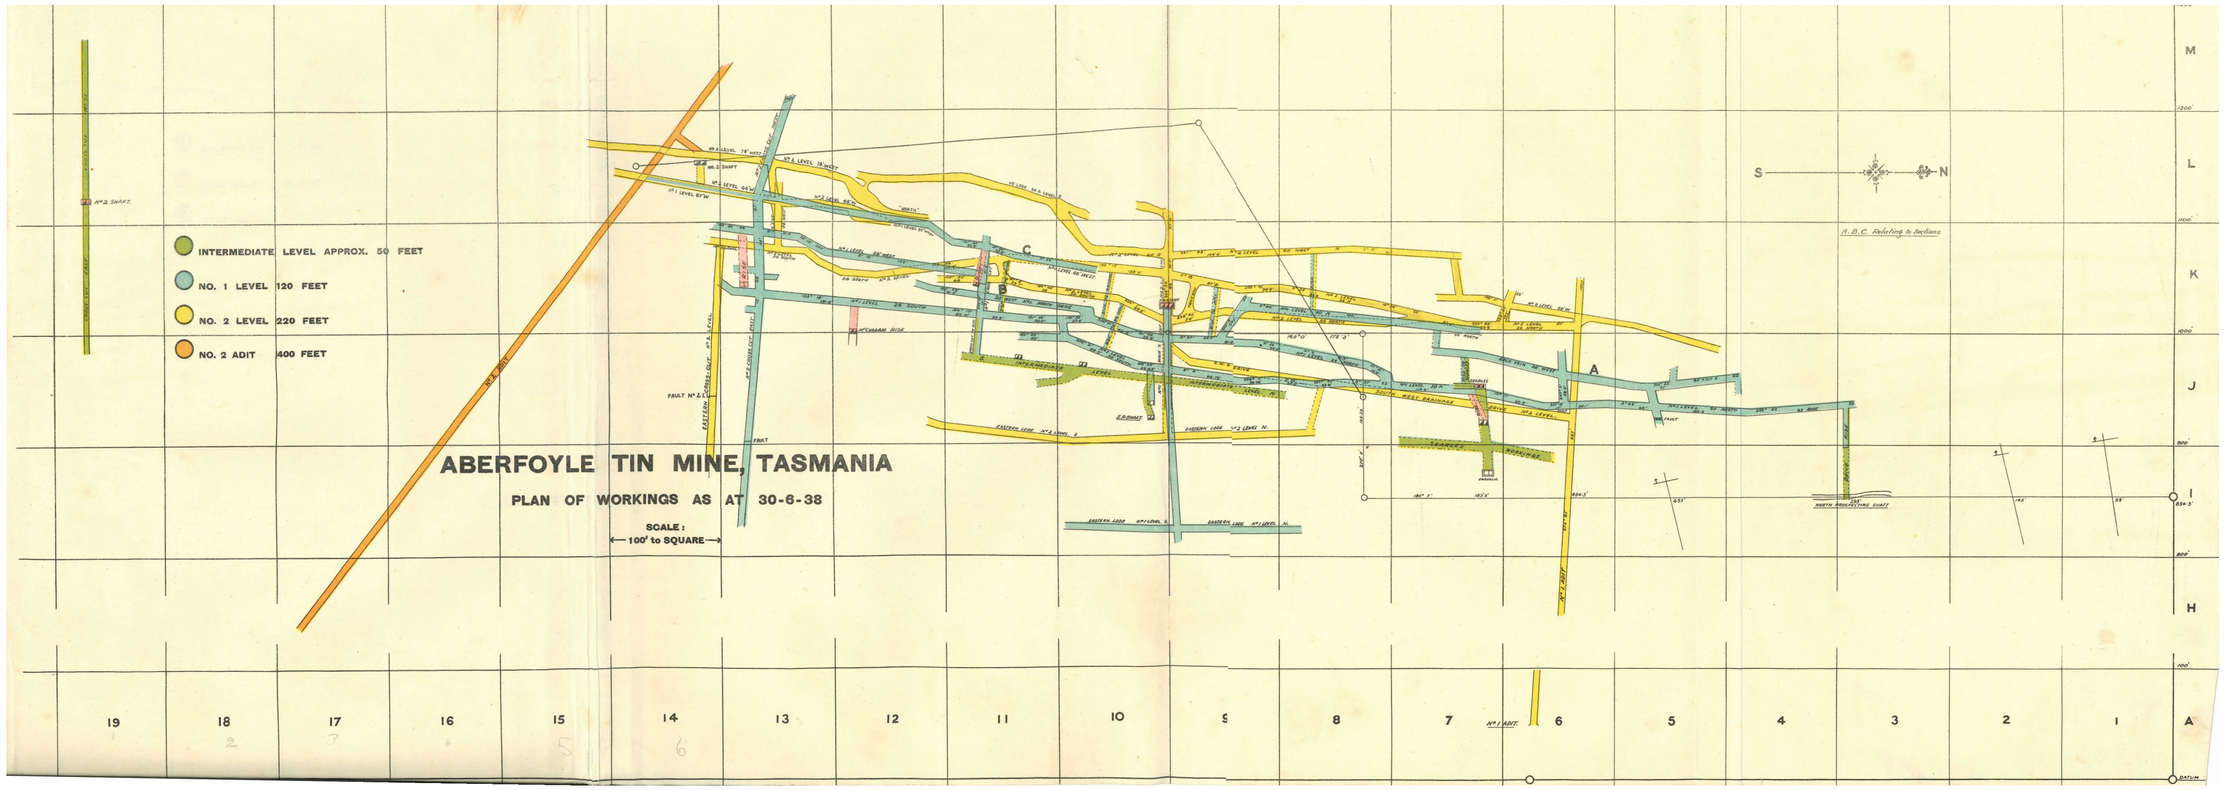
ABERFOYLE TIN MINE, TASMANIA
PLAN OF WORKINGS AS AT 30-6-38
SCALE:
100' to SQUARE
INTERMEDIATE LEVEL APPROX. 50 FEET
NO. 1 LEVEL 120 FEET
NO. 2 LEVEL 220 FEET
NO. 2 ADIT 400 FEET
S
N
A
B
C
M
L
K
J
I
H
A
19
18
17
16
15
14
13
12
11
10
9
8
7
6
5
4
3
2
1