000

71-193.

835001

MICROFILMED

E.L. 44/70 TASMANIA

(A.R.A. DODSON)

DUMP SAMPLING RESULTS

R.E. Besley
August, 1971

CONTENTS

1. Introduction
2. Sampling Procedure
3. Results.

TABLES

Table I Overall Averages
Table II Dumps sampled but not assayed

APPENDIX

Appendix I Assay Results Dump Sampling

PLATES

Plate 1. Zeehan Tasmania – Dump Locations EL 44/70

FIGURES

Figure 1. Niki Shaft Dumps
Figure 2. Niki Plant Dump
Figure 3. Niki Area (Top dump)
Figure 4. Large Dump (old adit) at Niki
Figure 5. E Tunnel Dump
Figure 6. Spray No.1 Shaft (Main dump)
Figure 7. Spray No.1 Shaft North Audit Dump
Figure 8. Spray No1. Shaft South-west Dump
Figure 9. Spray Mine Dump
Figure 10. Spray Adit Dump
Figure 11. Spray Adit Dump
Figure 12. Waste Dumps Swansea Area
Figure 13. Waste Dumps Oceana Area
Figure 14. Waste Dumps "Western" Area
Figure 15. Waste Dumps Silver Crown Area
Figure 16. Waste Dumps May Queen Area
Figure 17. Waste Dumps Spray Area
Figure 18. Waste Dumps Florence Area
Figure 19. Silver Bell Mine Dump as at 31/03/71

001

1. Introduction

A dump sampling program was initiated in late 1970 and was carried out during the first half of 1971 in conjunction with evaluation of mineralization within the Exploration Licence.

The purpose of the program was to determine if sufficient tonnage and grade of material was available to contribute significantly to the economics of a possible milling operation in the area.

A total of 20 dumps have so far been surveyed and sampled of which 14 have the assays completed.

2. Sampling Procedure

The larger dumps that are easily accessible were selected for sampling and surveyed. The method of sampling varied according to the geometry of the dump but in general samples were taken on 20 ft. intervals around the edge of the dump and from at least 2 ft. depth. The sample weight was between 5 and 10 lb.

3. Results

The location of the dumps is shown on Plate I. The sample positions and numbers are given on each individual plate for each dump. The complete assay results are given in Appendix I.

The 14 completed dumps have a total of 70,810 tons averaging 2.8 oz. Ag/ton, 1.4% Pb and 0.86% Zn. The averages are given in Table I. A total of 100,000 tons of material have been sampled.

The overall average grade is below the economic limit for milling operations. Individual dumps could be treated if a mill existed in the vicinity but the tonnages would be small.

002

TABLE I. OVERALL AVERAGES

835004

DUMP NO.	TONNAGE (long tons)	ARITHMETIC AVERAGE Ag (oz/tn)	Pb%	Zn%	Ag x Tonnage	Pb x Tonnage	Zn x Tonnage
1	6100	1.75	1.96	0.69	10700	1198	4210
2	3100	2.08	3.26	0.56	6460	10100	1740
3	1035	12.8	0.54	0.1	13250	559	104
4	7100	4.3	1.4	0.3	30500	9900	21300
5	1800	2.12	2.0	0.22	3820	3600	395
6	2800	1.06	1.05	1.57	2975	2942	4400
7	1720	0.93	1.57	0.72	1610	2700	1240
8	2900	3.72	1.52	0.57	10800	4410	1655
9	1500	5.55	3.94	0.44	8350	5900	660
10	1080	4.25	4.27	0.41	4600	4620	444
11	3000	2.6	1.81	0.18	7800	5430	540
	(765	0.33	1.06	0.61	252	811	467
	(						
12	(375	2.6	7.00	5.2	975	2620	1950
	(						
	(2350	0.44	1.77	0.81	1033	4160	1910
	(195	0.3	0.45	0.09	58	87	176
	(						
13	(8100	1.3	1.53	0.4	10520	12380	3240
	(						
	(555	0.4	1.07	0.4	222	593	222
	(						
	(75	2.00	3.9	0.46	150	292	35
	(1800	2.9	0.7	0.17	5220	1260	306
	(						
	(6000	2.26	0.77	0.9	13560	4620	540
	(						
14	(18000	3.52	1.60	0.83	63360	28800	14900
	(						
	(420	2.12	2.1	0.84	890	880	350
	(						
	(45	5.08	4.26	0.76	280	190	34
	70810				197365	99143	60818

14 dumps contains 70,810 tons averaging: 2.79 oz. Ag/ton
1.4 % Pb
0.86 % Zn

003

TABLE II. DUMPS SAMPLED BUT NOT ASSAYED

DUMP NO.	VOLUME Cu. Yds.	TONNAGE
	220	330
	110	165
	40	60
15	20	30
	2100	3150
	780	1170
	4300	6500
	80	120
	2370	3550
	110	165
16	1900	2850
	90	135
	40	60
	40	60
	110	165
	1020	1530
17	1180	1770
	50	75
	35	52
18	4100	6150
19	Not Surveyed	
20	1300	1950
	19995	30037

TOTAL TONNAGE SAMPLED = 100,800

004

APPENDIX I

ASSAY RESULTS DUMP SAMPLING

835007

005

Sample Rec. No.	Hg ozs/ton	Pb. %	Sb. PPM.	Zn. %	Cu. PPM.		
D.P. 0001	4·41	4·60	200	0·26	120		
0002	3·62	3·75	140	0·225	100		
0003	2·34	3·65	160	0·57	140		
0004	1·36	1·50	100	0·235	35		
0005A	0·71	0·75	160	0·57	160		
0005B	2·45	1·65	160	0·47	140		
0006A	1·28	1·05	100	1·05	240		
0006B	2·02	2·68	120	0·83	180		
0007	4·65	4·58	230	0·25	200		
0008	3·10	3·78	140	0·225	80		
0009	0·14	0·095	160	0·045	<35		
0010	1·08	1·32	120	0·17	35		
0011	12·10	8·20	460	0·31	480		
0012	5·08	4·40	260	~~1·13~~	120		
0013	13·40	7·85	650	1·92	440		
0014	11·00	6·60	300	0·585	200		
0015	1·24	0·78	<60	0·13	<35		
0016	0·10	0·04	<60	<0·02	<35		
0017	0·26	0·10	<60	0·20	<35		
0018	0·74	1·05	<60	<0·02	<35		
0019	0·43	0·03	<60	<0·02	<35		
0020	0·20	0·05	<60	<0·02	<35		
0021	0·14	0·65	<60	<0·02	<35		

Notes:- 1. Trace values only of Ni was found in these samples.

2. Sample 0009 has been investigated further by a type [illegible] of "silica" is recorded with these i.e. these appear to be [illegible] SiO_2, other than [illegible] SiO_2 / [illegible] Fe_2O_3 ([illegible]

Certified by W.J. GU[illegible]
CHIEF CHEMIST
KINGSGATE PTY. LTD.

NORMAN WOODS. PTY. LTD. 18 COLUMN STOCK DISSECTION BOOK

Sample Ref. No.		Ag. oz/ton	Sb. %	Zn. %	Pb. %			
DR. 0022		0.30	<0.03	0.011	0.26			
23		1.00	<0.03	0.048	0.09			
24		1.55	<0.03	0.031	0.35			
25		6.25	<0.03	0.004	0.385			
26		0.85	<0.03	0.014	0.33			
27		0.85	<0.03	0.875	0.33			
28		0.85	<0.03	0.033	0.385			
29		0.30	<0.03	0.040	0.05			
30		34.20	0.15	5.00	10.85			
31		0.20	<0.03	0.030	0.155			
32		<0.20	<0.03	0.030	0.14			
33		3.45	<0.03	0.085	0.73			
34		0.20	<0.03	0.415	0.25			
35		N.D.	<0.03	0.019	0.09			
36		<0.20	<0.03	0.014	0.40			
37		<0.20	<0.03	0.029	0.16			
38		2.70	<0.03	0.014	0.60			
39		0.50	<0.03	0.010	0.16			
40		0.50	<0.03	0.007	0.16			
41		0.60	<0.03	0.005	0.05			
42		2.10	<0.03	0.420	0.43			
43		4.10	0.05	0.540	1.19			
44		4.60	0.05	0.590	1.46			
45		3.20	<0.03	0.660	1.10			
46		6.65	0.05	0.980	2.34			
47		4.50	0.03	1.40	1.96			
48		6.00	0.05	1.12	2.50			
49		6.00	0.05	1.05	2.63			
50		4.40	0.03	0.890	1.67			

NORMAN WOODS PTY. LTD.

21/12/10.

007

ORMAN BROS. PTY. LTD. 18 COLUMN STOCK DISSECTION BLOCK

SAMPLE REF. No.		Ag. oz/ton	Sb. %	Zn. %	Pb. %			
DR.0051		1.10	<0.03	0.66	1.82			
52		0.35	<0.03	0.19	0.62			
53		0.50	<0.03	0.26	0.79			
54		<0.20	<0.03	0.04	0.26			
55		0.50	0.05	0.24	0.75			
56		0.70	<0.03	0.37	0.99			
57		0.35	<0.03	0.18	0.51			
58		2.40	0.07	2.44	3.82			
59		4.85	<0.03	0.45	1.90			
60		0.85	<0.03	0.14	0.79			
61		0.40	<0.03	0.06	0.65			
62		1.00	<0.03	0.50	1.15			
63		0.20	<0.03	0.08	0.33			
64		2.60	<0.03	2.48	3.90			
65		0.50	<0.03	1.09	0.46			
66		1.65	<0.03	0.07	1.85			
67		0.80	<0.03	1.40	0.99			
68		4.35	<0.03	1.02	5.15			
69		7.95	0.13	0.79	10.35			
70		2.20	<0.03	1.30	3.35			
71		0.85	<0.03	0.22	0.77			
72		1.00	<0.03	0.18	1.65			
73		5.00	0.15	2.34	5.50			
74		<0.20	<0.03	0.04	0.15			
75		0.85	<0.03	0.07	0.76			
76		1.15	<0.03	0.31	0.76			
77		0.85	0.06	0.19	1.25			
78		1.00	0.34	0.24	1.53			
79		6.25	0.06	2.06	5.78			
80		0.55	0.06	0.29	0.84			
81		2.60	0.11	1.11	3.09			
82		1.95	0.03	0.03	1.33			
83		1.85	<0.03	0.46	1.00			
84		2.30	0.18	0.44	2.40			
85		1.70	0.09	0.52	2.02			
86		1.35	0.05	0.03	2.00			
87		3.45	<0.03	0.09	3.65			
88		1.40	<0.03	0.31	1.72			
89		0.30	<0.03	0.29	1.35			
90		0.60	<0.03	0.02	0.24			
91		3.35	~~<0.03~~ 0.06	0.66	3.70			
92		2.50	<0.03	0.47	2.82			

21/12/

008

Sample Ref. No.		Ag oz/ton	Sb. %	Zn. %	Pb. %	Cu. %		
DR. 0093		58.10	0.14	0.03	0.41	0.01		
94		1.63	0.02	0.20	1.64	<0.01		
95		21.60	0.12	0.02	0.35	0.01		
96		17.40	0.10	0.02	0.34	0.01		
97		0.49	0.02	0.07	0.21	<0.01		
98		0.73	0.03	0.39	0.77	<0.01		
99		0.24	<0.02	0.09	0.46	<0.01		
0100		2.80	0.03	0.04	0.18	<0.01		
101		31.10	0.17	8.32	32.20	0.04		
102		3.94	0.04	6.25	1.68	0.44		
103		7.98	0.57	7.13	7.99	0.08		
104		14.30	3.74	5.71	20.30	0.20		
105		12.15	0.61	20.10	15.00	0.17		
106		— SAMPLE — SCRAPPED —						
107		6.49	<0.02	0.06	0.36	<0.01		
108		8.56	0.03	0.02	0.23	<0.01		
109		1.30	<0.02	0.07	0.42	<0.01		
110		0.24	<0.02	0.02	2.88	<0.01		
111		1.06	<0.02	0.11	0.75	<0.01		
112		1.80	0.02	0.10	0.97	0.01		
113		3.05	0.03	0.10	1.11	0.02		
114		1.63	0.03	0.09	1.68	0.01		
115		3.05	0.03	0.66	2.85	0.03		
116		1.63	0.03	0.02	0.31	<0.01		
117		2.59	0.03	0.37	1.52	0.01		
118		5.38	0.04	0.37	7.00	0.01		
119		3.16	0.02	0.18	1.18	<0.01		
120		0.83	0.02	0.17	1.24	<0.01		
121		48.50	0.03	0.03	0.26	<0.01		
122		9.07	0.03	0.20	2.70	0.02		
123		0.33	0.01	N.D.	0.13	<0.01		
124		5.76	0.02	0.17	3.00	0.01		
125		1.16	0.02	N.D.	0.16	<0.01		
126		3.14	0.03	0.02	0.51	<0.01		
127		0.66	0.02	0.02	0.59	<0.01		
128		0.72	N.D.	N.D.	0.36	<0.01		
129		0.50	N.D.	N.D.	0.23	<0.01		
130		0.33	N.D.	0.02	0.07	N.D.		
131		1.16	0.02	2.55	2.00	0.02		
132		0.83	0.02	2.50	2.00	0.02		
133		12.40	0.07	25.00	14.54	0.17		

(N.D. = NOT DETECTABLE).

009

835011

Sample Ref. No.		Ag oz/ton.	Sb. %	Zn. %	Pb. %	Cu. %	
DR. 0134		4.12	0.05	0.03	0.40	<0.01	
135		1.92	0.07	0.27	1.93	<0.01	
136		2.05	0.04	0.12	2.27	<0.01	
137		0.33	0.02	0.07	0.51	N.D.	
138		N.D.	0.02	0.15	0.05	N.D.	
139		0.23	0.01	0.05	0.38	<0.01	
140		2.15	0.09	0.32	3.19	<0.01	
141		1.82	0.08	0.27	2.51	0.02	
142		8.25	0.08	0.27	6.80	0.02	
143		0.99	0.07	0.05	1.36	<0.01	
144		1.82	0.09	0.12	2.51	<0.01	
145		1.82	0.05	0.35	2.12	0.02	
146		12.90	0.44	8.60	18.60	0.065	
147		0.50	0.01	1.35	0.64	<0.01	
148.		0.23	0.01	1.15	0.19	<0.01	
149.		T.	0.03	0.45	0.18	T	
150		N.D.	0.03	0.25	0.11	T	
151		1.11	0.065	1.48	1.10	0.02	
152		T.	0.08	0.11	0.35	T	
153		1.63	0.05	1.90	1.57	0.02	
154		0.41	0.03	0.45	0.34	T	
155		2.69	0.05	3.38	2.58	0.04	
156		0.98	0.03	1.82	1.37	0.02	
157		T.	T	0.03	T	T	
158		3.10	0.61	4.22	3.17	0.05	
159		T.	0.02	0.05	0.03	T	
160		6.42	0.55	6.48	5.75	0.11	
161		1.11	0.06	4.53	0.67	0.02	
162		N.D.	0.02	0.05	0.02	0.01	
163		1.11	0.03	0.41	0.78	T	
164		T.	T.	0.08	0.03	T	
165		5.09	0.14	4.22	6.77	0.05	
166		1.11	0.02	0.74	1.35	0.02	
167		2.82	0.12	4.00	4.19	0.07	
168		N.D.	T.	0.02	0.03	T	
169		2.69	0.04	0.18	6.35	T	
170		N.D.	0.02	0.16	0.07	T	
171		T.	T.	0.35	0.29	T	

010

835012

Sample Ref. No.		Ag. ozs/ton.	Sb. %	Zn. %	Pb %	Cu %		
DF. 0172		0.49	0.02	0.16	0.33	T		
173		0.49	0.02	0.14	0.40	T		
174		0.78	0.02	0.31	1.07	0.01		
175		0.98	0.05	1.04	1.95	0.02		
176		4.72	0.14	0.75	3.50	0.02		
177		5.50	0.20	0.07	0.90	0.05		
178		4.01	0.07	0.26	3.26	T		
179		T	0.01	0.01	0.04	T		
180		1.63	0.17	0.03	1.95	0.01		
181		2.45	0.06	0.26	1.57	0.02		
182		0.25	0.02	1.26	0.23	0.02		
183		0.25	0.03	0.03	0.07	T		
184		1.79	0.05	0.01	0.45	0.02		
185		13.15	0.24	0.04	2.45	0.06		
186		0.90	0.06	0.08	0.82	0.01		
187		0.75	0.04	0.04	0.75	T		
188		0.75	0.03	0.26	0.06	T		
189		15.58	0.38	5.40	6.95	0.05		
190		24.15	0.37	29.50	15.30	0.28		
191		3.58	1.78	12.35	6.60	0.06		

Please Note: Samples no. DF. 0146 ; DF. 0165 ; DF. 0175 ; DF. 0190 ; DF. 0191 . will be analysed for Au, Sn, Ts at end of programme unless otherwise advised.

27/1/71.

011

835013

Sample Reg. No.		Ag ozs/ton.	Sb. %	Zn. %	Pb. %	Cu. %		
DF. 0192		5.76	0.15	0.05	2.80	0.02		
0193		0.66	0.03	0.03	0.30	N.D.		
194		5.27	0.19	0.35	5.60	0.01		
195		4.22	0.17	0.03	0.88	0.02		
196		4.94	0.21	0.50	5.60	0.02		
197		12.00	0.26	0.12	6.80	0.02		
198		9.20	0.32	0.16	4.90	0.02		
199		5.93	0.18	0.35	4.35	0.02		
200		5.93	0.35	2.50	4.35	0.03		
201		1.65	0.11	0.35	1.75	0.01		
202		6.10	0.38	0.68	6.20	0.02		
203		5.21	0.47	0.17	3.77	T		
204		19.20	0.21	25.50	18.20	0.24		
205		6.73	0.05	0.17	5.70	0.01		
206		0.17	0.02	0.01	0.22	N.D.		
207		6.86	0.06	0.58	8.60	0.01		
208		1.06	0.02	0.02	0.57	N.D.		
209		6.53	0.09	1.42	6.60	0.02		
210		19.20	0.20	6.15	14.30	0.05		
211		1.55	0.21	0.12	1.60	T.		
212		3.14	0.02	0.15	2.38	T.		
213		2.78	0.02	0.10	2.13	0.01		
214		2.91	0.02	0.03	2.05	0.01		
215		5.05	0.03	0.40	3.32	0.02		
216		2.91	0.03	0.08	1.92	T.		
217		3.30	0.02	0.05	3.05	T.		
218		1.32	0.02	0.04	0.54	T.		
219		1.55	0.02	0.05	1.26	T.		
220		3.57	0.06	0.35	1.12	0.01		
221		0.50	0.03	0.05	0.54	N.D.		
222		32.00	4.83	1.55	19.60	0.10		

4/2/71.

835014

Sample Ref. Nos.	Type	Description.	Ag. ozs.	Sb. %	Pb %	Zn. %	Cu. %
DR. 0223	GRAB	SAMPLES	0.33	0.02	0.40	2.35	0.01
0224	"		0.17	0.01	0.40	0.07	N.D.
0225	"		0.83	0.02	0.73	1.05	0.04
0226	"		0.17	0.02	0.75	0.60	0.02
0227	"		0.17	0.01	0.24	0.03	<0.01
0228	"		0.17	0.01	0.33	0.03	N.D.
0229	"		0.33	0.06	1.75	0.40	0.10
0230	"		0.66	0.09	3.05	0.30	0.12
0231	"		0.33	0.01	1.30	0.05	N.D.
0232	"		0.43	0.01	2.40	2.35	0.02
0233	"		1.06	0.03	4.30	2.05	0.08
0234	"		0.17	N.D.	0.88	0.10	<0.01
0235	"		0.17	0.01	0.02	0.05	0.08
0236	"		0.17	0.01	0.07	0.15	<0.01
0237	"		0.17	0.03	0.12	0.03	0.04
0238	"		0.50	0.02	2.75	1.65	0.02
0239	"		1.32	0.03	8.80	4.85	0.05
0240	"		1.06	0.30	2.20	0.32	0.35
0241	"		N.D.	0.01	0.25	0.58	0.01
0242	"		0.33	0.03	0.97	0.10	<0.01
0243	"		N.D.	N.D.	0.19	0.10	<0.01
0244	"		N.D.	N.D.	0.02	N.D.	<0.01
0245	"		0.17	0.01	0.64	0.15	0.02
0246	"		0.50	0.02	3.65	1.73	0.03
0247	"		0.50	0.02	2.68	0.23	0.01
0248	"		0.80	0.19	2.73	0.85	0.13
0249	"		0.43	0.02	2.02	0.10	0.01
0250	"		0.43	0.03	1.05	0.08	0.01
0251	"		0.50	0.03	2.65	1.03	0.03
0252	"		1.85	0.05	7.80	0.43	0.03
0253	"		0.17	0.03	0.37	0.08	0.01
0254	"		0.43	0.06	1.85	1.08	0.06
0255	"		0.50	0.03	2.32	0.04	<0.01
0256	"		2.97	0.24	8.00	9.25	0.35
0257	"		0.17	0.02	0.36	0.08	0.13
0258	"		0.38	0.08	1.70	0.10	0.03
0259	"		0.66	0.03	2.57	0.15	0.02
0260	"		0.33	0.03	1.20	0.03	0.01
0261	"		0.33	0.02	1.48	0.03	<0.01
0262	"		<0.25	0.02	0.05	0.01	<0.01
0263	"		0.17	0.02	0.06	0.03	<0.01
0264	"		N.D.	N.D.	0.03	0.03	<0.01
0265	"		0.50	0.03	1.55	6.65	0.03

013

835015

Sample Ref. Nos.	Type/ Description	Ag. oz/ton.	Sb. %	Pb. %	Zn. %	Cu. %	Bi.
DA. 0266	Grab Samples	5.27 [illegible]	0.67	2.23	3.00	0.83	
0267	"	1.98 [illegible]	0.08	9.80	10.00	0.07	
0268	"	0.83 [illegible]	0.06	2.57	3.85	0.07	
0269	"	4.07	0.41	15.40	8.75	0.28	
0270	"	2.15	0.25	8.30	1.35	0.20	
DA. 0271	Not Stated	3.30	0.10	8.70	2.85	0.15	
DA. 0293	Picked Samples High Grade Dump	4.93	1.98	16.15	6.15	1.50	N.D.
0294	"	3.45	5.90	24.80	3.10	3.56	N.D.

Certified by W. J. GUTHRIE
[illegible]
MINORS PTY. LTD.

[illegible] 5/3/71.

835016

Sample Ref. No.	Type	Description	Ag. ozs/ton	Sb. %	Pb. %	Zn. %	Cu. %
DA.0273	Grab	Sample	2.05	0.04	4.71	0.48	0.02
0274	"	"	<0.25	0.03	0.09	0.07	<0.01
0275	"	"	<0.25	0.03	0.06	0.04	<0.01
0276	"	"	<0.25	0.03	0.03	0.03	<0.01
0277	"	"	0.50	0.03	1.35	0.24	<0.01
0278	"	"	0.40	0.03	0.73	0.25	<0.01
0279	"	"	<0.25	0.03	0.32	0.09	<0.01
0280	"	"	0.80	0.03	1.67	0.53	0.01
0281	"	"	2.00	0.05	3.90	0.46	0.02
0282	"	"	5.08	0.07	10.00	0.94	0.04
0283	"	"	1.69	0.04	2.37	0.63	0.02
0284	"	"	3.42	0.05	2.20	1.16	0.03
0285	"	"	0.25	0.04	0.96	0.27	0.09
0286	"	"	0.50	0.04	1.22	0.52	0.01
0287	"	"	0.50	0.04	1.25	0.28	<0.01
0288	"	"	0.25	0.03	0.78	0.42	<0.01
0289	"	"	0.40	0.04	1.03	0.38	<0.01
0290	"	"	0.25	0.03	0.09	0.05	<0.01
0291	"	"	0.40	0.04	0.72	0.09	<0.01
0292	"	"	0.25	0.03	0.53	0.15	<0.01

5/3/71.

015

Assay. Ref. No.	Type /	Description	Ag oz/ton	Sb %	Pb. %	Zn %	Cu. %	
D.A 0293	Grab	Sample	1·87	0·03	1·17	1·31	0·02	
0294	"	"	3·14	0·04	1·93	1·38	0·04	
0295	"	"	2·81	0·02	1·62	0·90	0·02	
0296	"	"	3·30	0·03	1·35	1·58	0·04	
0297	"	"	0·50	0·03	0·37	0·25	<0·01	
0298	"	"	3·30	0·04	2·13	0·30	0·03	
0299	"	"	2·81	0·31	1·38	1·04	0·04	
0300	"	"	4·62	0·04	2·58	0·85	0·05	
0301	"	"	4·35	0·07	3·00	0·45	0·02	
0302	"	"	←	No	Sample	Received	→	
0303	"	"	3·79	0·05	2·22	0·65	0·02	
0304	"	"	3·63	0·04	1·28	2·55	0·03	
0305	"	"	3·14	0·04	1·60	2·18	0·04	
0306	"	"	3·96	0·05	1·56	1·28	0·04	
0307	"	"	4·40	0·04	2·92	1·58	0·05	
0308	"	"	4·29	0·05	2·00	1·45	0·05	
0309	"	"	3·22	0·07	2·05	0·70	0·02	
0310	"	"	3·14	0·04	1·53	1·07	0·04	
0311	"	"	1·03	0·03	0·67	0·08	<0·01	
0312	"	"	4·45	0·05	1·72	1·30	0·05	
0313	"	"	0·83	0·02	0·56	0·17	0·01	
0314	"	"	5·75	0·06	1·97	1·70	0·06	
0315	"	"	3·46	0·13	1·90	0·64	0·03	
0316	"	"	8·40	0·06	2·78	0·64	0·06	
0317	"	"	6·91	0·06	2·55	0·70	0·06	
0318	"	"	4·29	0·08	1·53	0·97	0·04	
0319	"	"	8·40	0·05	3·73	0·34	0·11	
0320	"	"	5·75	0·04	1·93	0·70	0·04	
0321	"	"	3·14	0·08	1·45	0·30	0·03	
0322	"	"	4·40	0·04	1·48	0·47	0·04	
0323	"	"	2·14	0·04	0·99	0·73	0·02	
0324	"	"	0·90	0·03	0·56	0·67	0·01	
0325	"	"	5·05	0·04	1·78	0·74	0·05	
0326	"	"	5·05	0·04	1·06	0·85	0·07	
0327	"	"	3·10	0·05	1·16	0·33	0·02	
0328	"	"	4·65	0·05	1·30	0·47	0·05	
0329	"	"	4·25	0·05	1·38	0·35	0·04	
0330	"	"	3·60	0·05	1·20	0·37	0·04	
0331	"	"	0·90	0·03	0·61	1·05	0·02	
0332	"	"	0·65	0·02	0·52	0·52	0·01	
0333	"	"	2·94	0·04	1·12	0·75	0·04	
0334	"	"	2·85	0·04	1·41	0·72	0·07	

016

835018

Assay Ref. No.	Type	Description	Hg. gm/t	Sb. %	Pb. %	Zn. %	Cu. %
DR.0335	GRAB	SAMPLE	3.38	0.04	1.20	1.29	0.04
336	"	"	6.65	0.06	1.98	0.80	0.05
337	"	"	8.15	0.06	3.28	0.87	0.07
338	"	"	1.02	0.02	1.48	0.07	<0.01
339	"	"	<0.30	<0.02	0.20	0.02	<0.01
340	"	"	2.32	<0.02	2.14	0.07	<0.01
341	"	"	3.50	0.04	2.05	1.87	0.04
342	"	"	3.00	0.05	1.25	0.38	0.02
343	"	"	2.52	0.04	0.86	0.79	0.03
344	"	"	1.45	<0.02	0.65	0.35	0.02
345	"	"	3.50	0.04	1.61	1.45	0.05
346	"	"	2.60	0.02	0.83	1.31	0.03
347	"	"	0.80	0.02	0.45	0.13	0.01
348	"	"	1.30	0.02	0.75	0.20	0.01
349	"	"	1.80	0.04	0.80	0.75	0.02
350	"	"	1.65	<0.02	0.57	0.95	0.03
351	"	"	3.55	0.03	0.72	1.66	0.13
352	"	"	2.97	0.02	0.57	1.40	0.04
353	"	"	1.82	0.02	0.65	0.95	0.02
354	"	"	3.14	<0.02	0.82	0.85	0.04
355	"	"	2.81	<0.02	0.76	0.07	0.05
356	"	"	4.28	0.02	0.72	0.58	0.11
357	"	"	5.27	0.03	0.82	0.13	0.10
358	"	"	0.99	<0.02	0.54	0.02	0.03
359	"	"	1.16	<0.03	0.57	0.03	0.02
360	"	"	3.14	0.02	1.43	1.74	0.04
361	"	"	2.40	0.03	1.28	0.88	0.04
362	"	"	2.97	0.03	1.05	0.73	0.03
363	"	"	5.76	0.03	4.89	0.93	0.01
364	"	"	4.12	0.03	3.97	0.14	<0.01
365	"	"	3.39	0.04	3.73	1.53	0.01
366	"	"	3.80	0.02	2.70	0.30	0.01
367	"	"	3.39	<0.02	3.45	1.15	0.01
368	"	"	10.00	0.05	6.80	0.50	0.02
369	"	"	1.16	<0.02	1.10	0.93	<0.01
370	"	"	2.81	0.02	2.65	0.13	0.01
371	"	"	0.41	<0.02	0.46	1.05	<0.01
372	"	"	4.12	0.03	4.13	1.27	0.01

Last Sample Assayed

30-3-71 CM

835019

ZEEHAN QUEEN

CONSD. LEASE
36M/62 40
D.Dunkley
M.L.

CEMETERY RESERVE

11859/M 10
11861/M
11817/M 10
9688/M 5
11805/M 48

11912/M 79

53M/68 10
B.F.Groves and others
M.L.

NEW MT. ZEEHAN

59M/66 10
RENISON LTD
M.L.

4067/M 74
ZEEHAN

8701/M 40

14M/63 50 No.4

53M/68 10
B.F.Groves and others
M.L.

9056/M 5
No.1

943/M 40
FLORENCE

2814/M 12

Queen Hill
SILVER QUEEN
ARGENT No.2
No.5 No.3 No.6
STATE ARGENT

11982/M 38
11983/M 39
546/M 76
11977/M 80

① Niki Shaft Dump
② Niki plant dump
③ Niki top dump
④

BOTANICAL GARDENS RESERVE

11867/M 5
11869/M 5
11868/M 5
11870/M 5
11871/M 5
BALSTRUPS
MANGANESE HILL
Manganese Hill
Keel Ridge
4467/M 79
1780/M 60
3427/M 10
11976/M

GRUBBS
TRAMWAY

⑦ ⑥ ⑤ E.Tunnel Dump
⑧ ⑨ ⑩ SPRAY
11872/M 10
7604/M 5
CENTRAL BALSTRUP
Austral
10 0 38 C.A. Wilson Pur.
19 3 31 W.H.Male Pur.

10256/M
3699/M

108M/67 2
Sievers and K.J.Cooney M.L.
⑪

11676/M 10

7175/M 40
306/M 40
MONTAGU
WATTS and McAULIFFE
2851/M 192

VICTORIA ZEEHAN
COLONEL NORTH
8703/M 78
7281/M 40
6954/M 39
NTH. AUSTRAL
MAXIM

65

8997/M
11758/M 20
901/M
1888/M 14

8998/M 20
6241/M 79
NUBEENA
5982/M
AUSTRAL VALLEY

NTH. TASMANIAN
10M/42 40
5862/M 20
GRUBBS
10339/M 40
7227/M 5
Pur
ELECT.

TASMANIAN
10M/70 50
S.A.Clark M.L.
⑫
3465/M 80
6739/M 77
STH. NUBEENA
2127/M 60

SWANSEA
17M/63 5 C.I.Clark M.L.
9W/48
McClean
1811/M 71
3424/M

1971/M 30
7837/M 10
7559/M 10
⑬
10608/M 5
31M/46 17
1913/M 80
678/87M 80
8103/M 20

Plate 1.

TENNECO AUSTRALIA, INC.

ZEEHAN TASMANIA

DUMP LOCATIONS

E.L. 44/70

Scale: 1" = 20 chns.
Date: August 6, 1971

Mine dumps which have been surveyed (compass and tape offsets) and sampled.

5 cm

NIKI SHAFT DUMPS

Figure 1

018

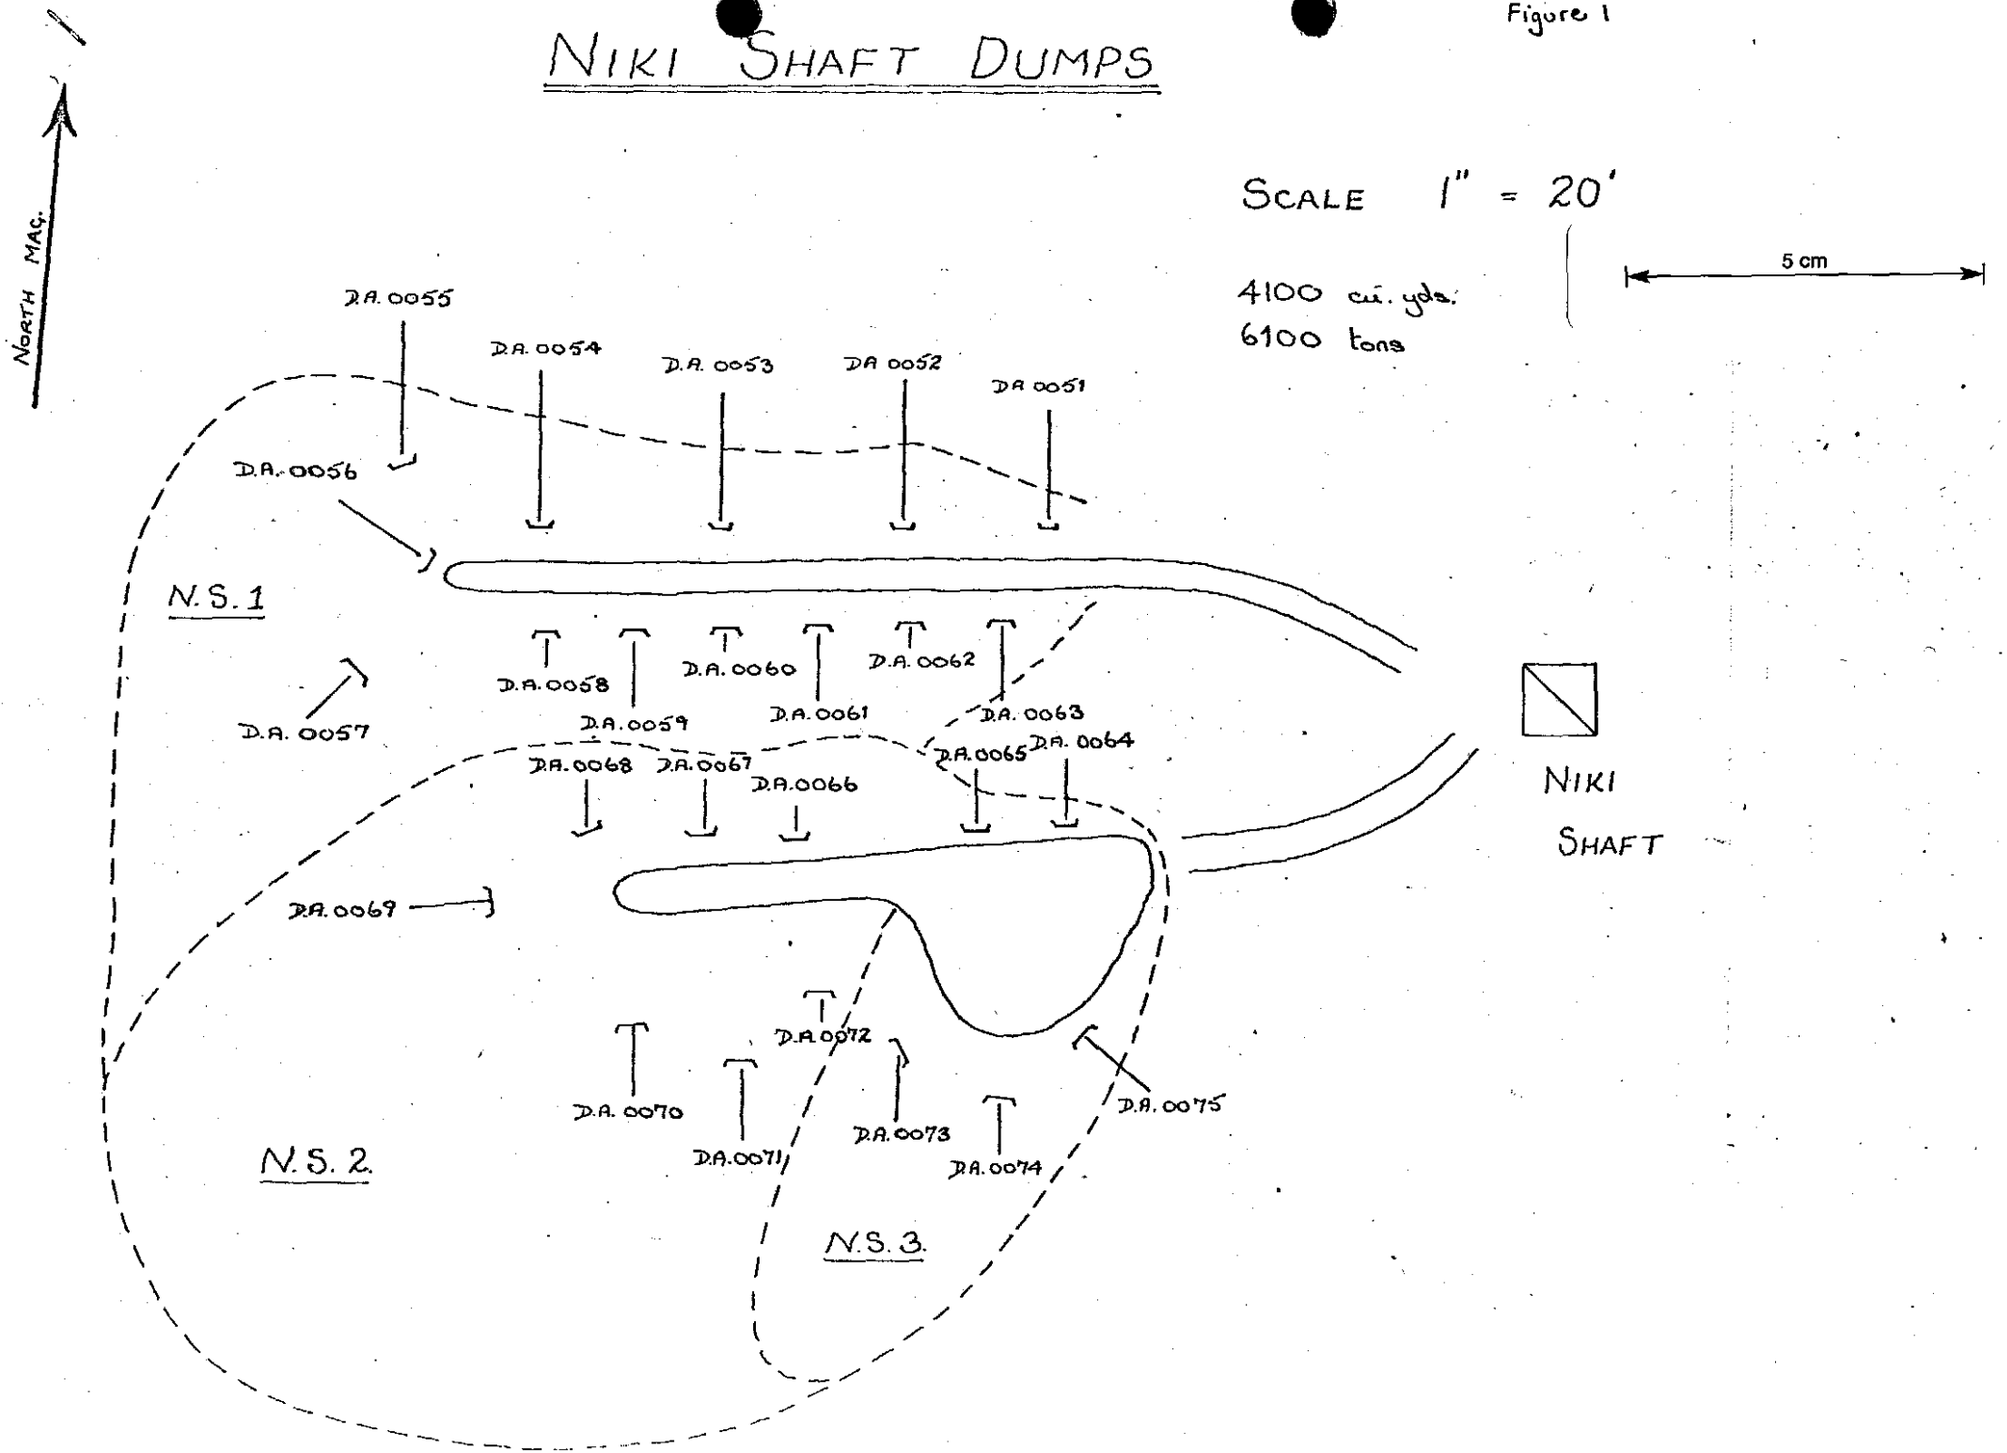

8350020

835021

019

5 cm

FIGURE 2

SCALE
1" = 50'

7/12/70

NIKI PLANT DUMP

No. 1

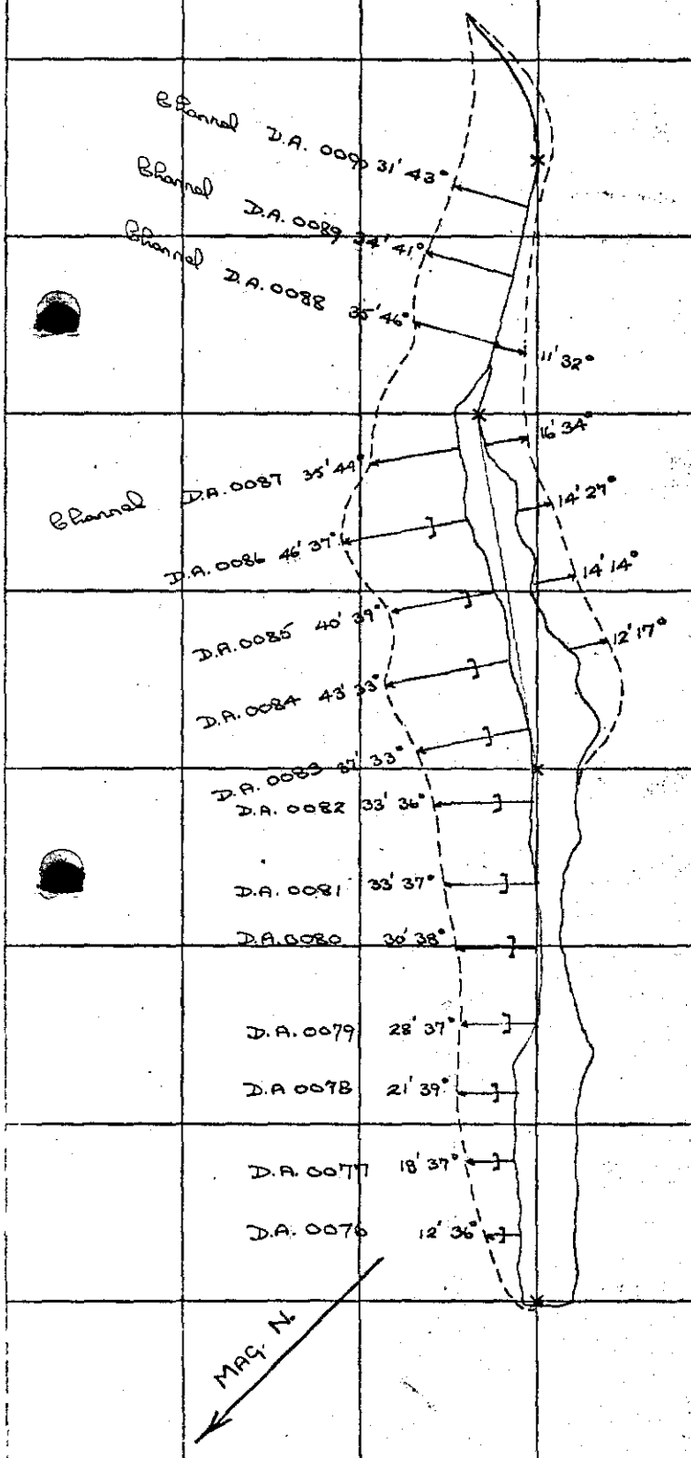

2060 cu. yds.
3100 tons

0	0
7	0
7	6
8	5
5	8
4	6
2	9
3	11
2	14
1	18
2	12
1	11
2	12
0	7
0	7
0	6
-1	9
0	12
4	16
6	14
6	14
6	12
5	12
5	11
6	11
×	ORIGIN

Width of Crest From Baseline in Feet.

No 2

Small dump N. of 1

Two channel samples taken across the layering

D.A. 0091 (east side)

D.A. 0092 (west side)

"ALBANENE" No. 195M KALCO., N.Y.
REG. U.S. PAT. OFF

020

835022

5 cm

FIGURE 3

SCALE
1" = 20'

31 | 12 | 70

NIKI AREA (TOP DUMP)

690 cu yds
1035 tons

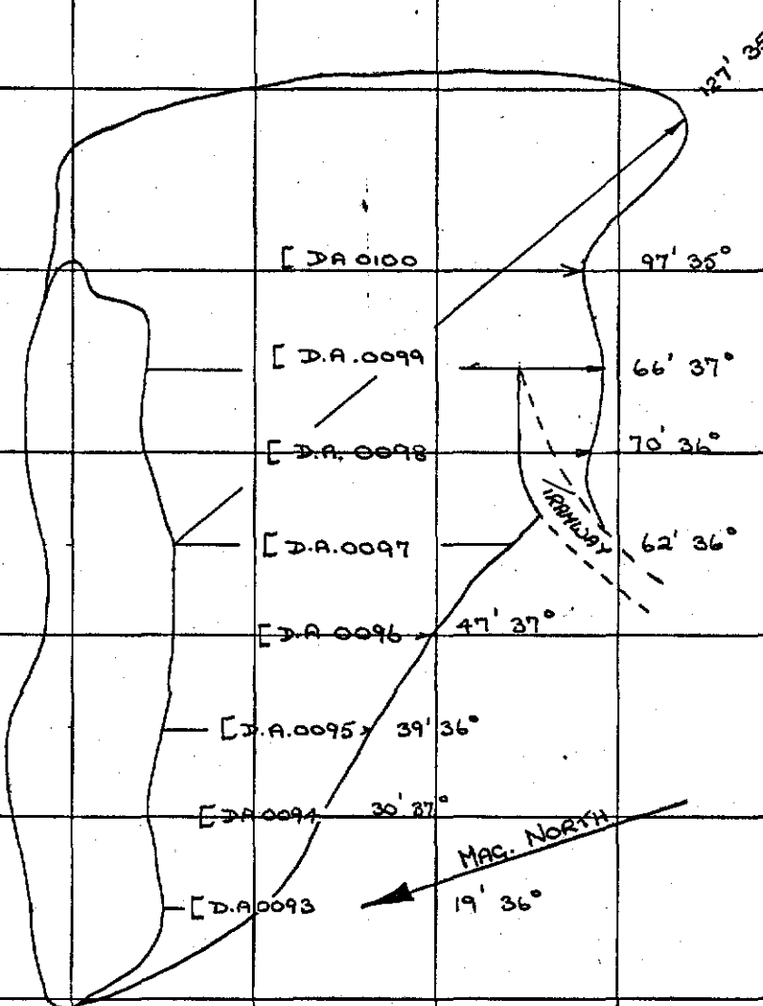

"ALBANENE" NO. 185M K & E CO., N. Y.
REG. U.S. PAT. OFF

835023

021

5 cm

FIGURE 4

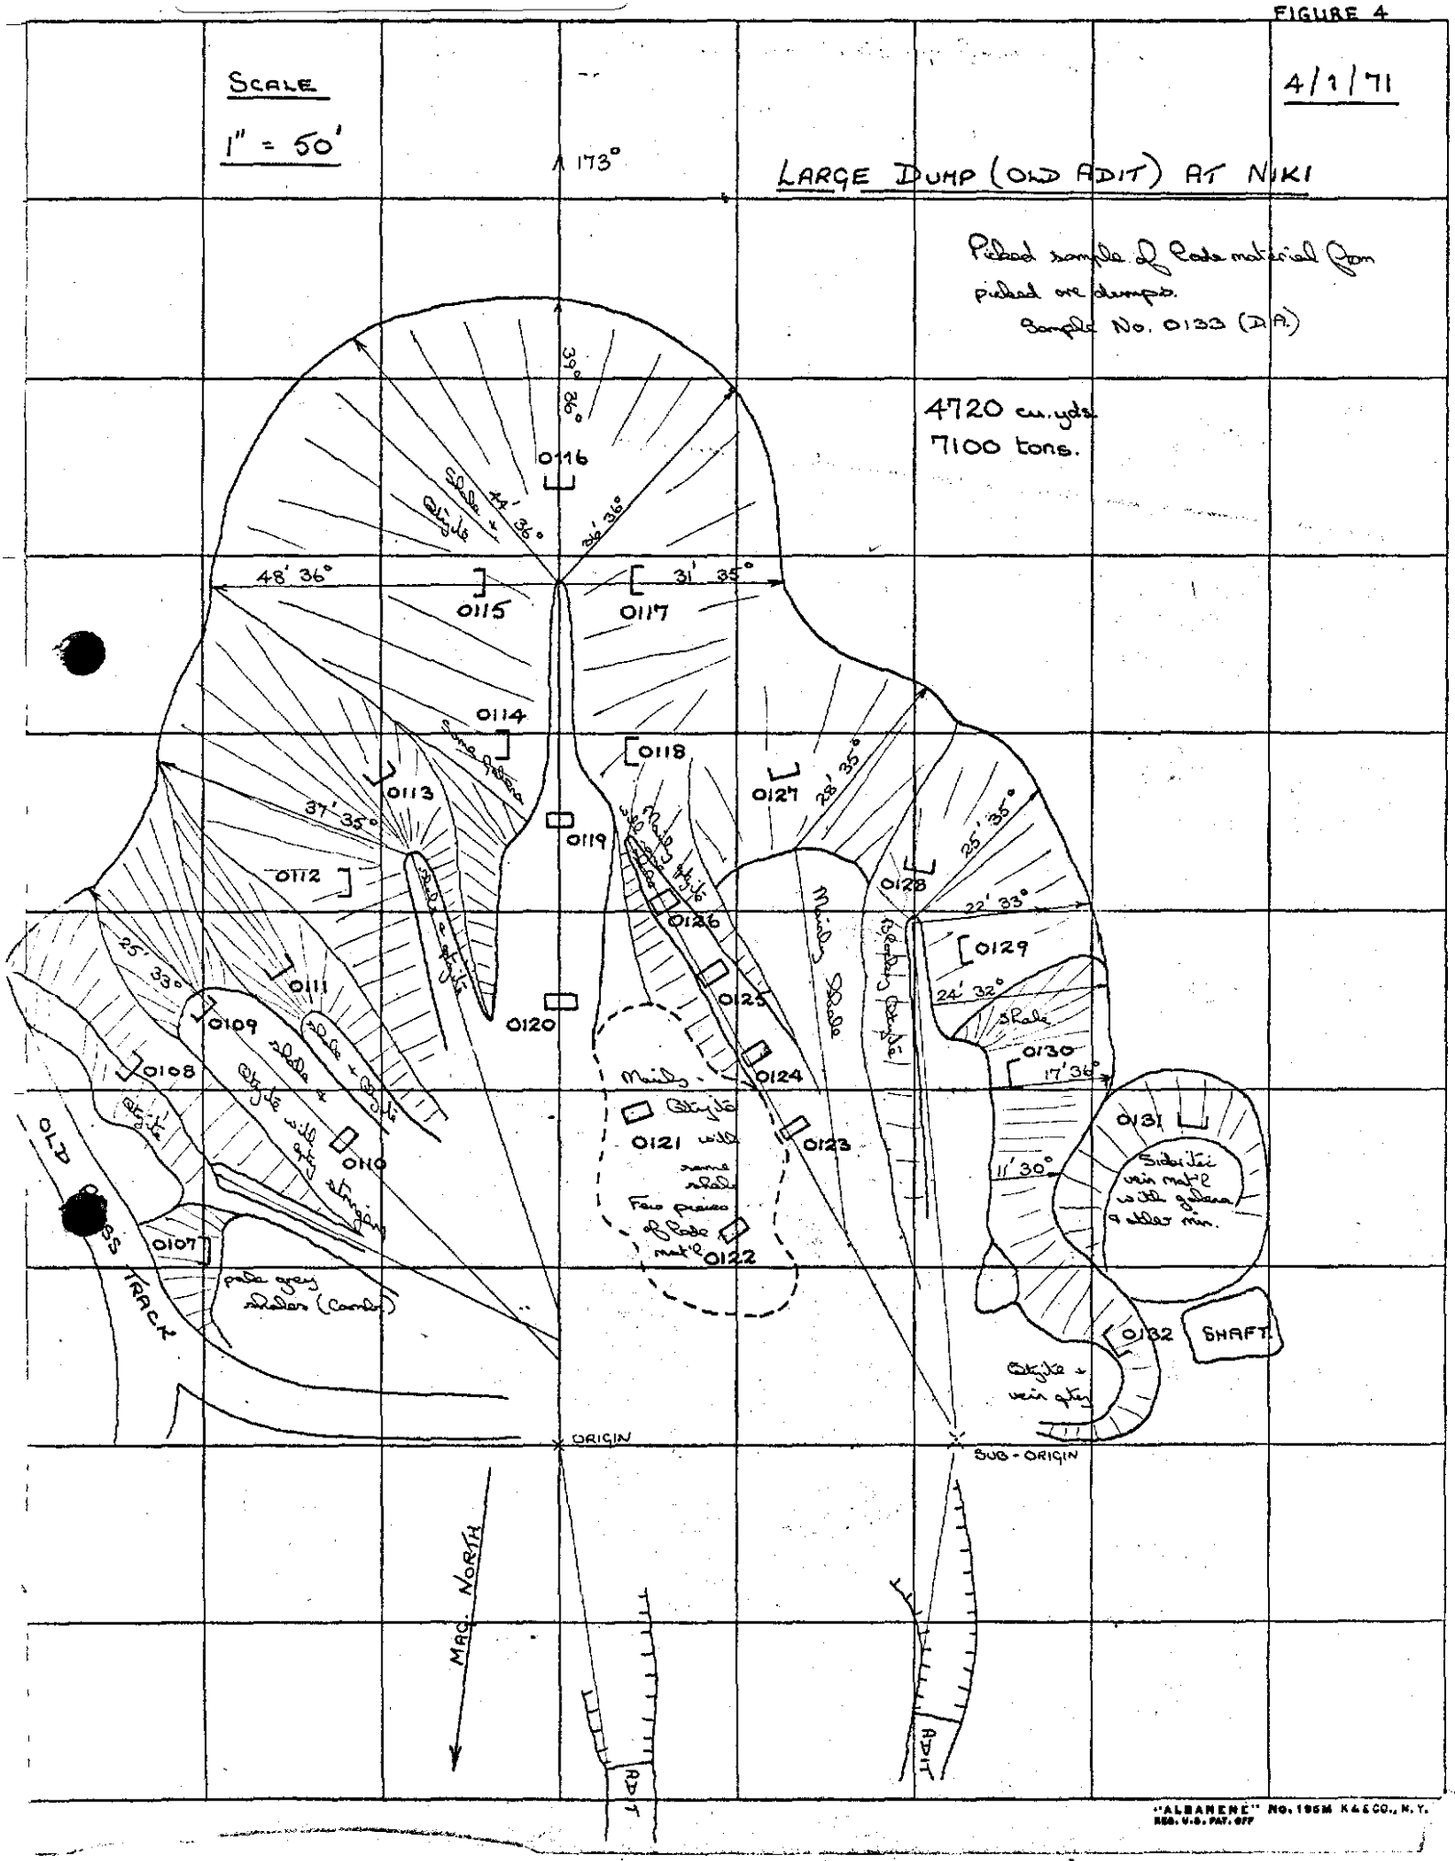

022

835024

5 cm

FIGURE 5

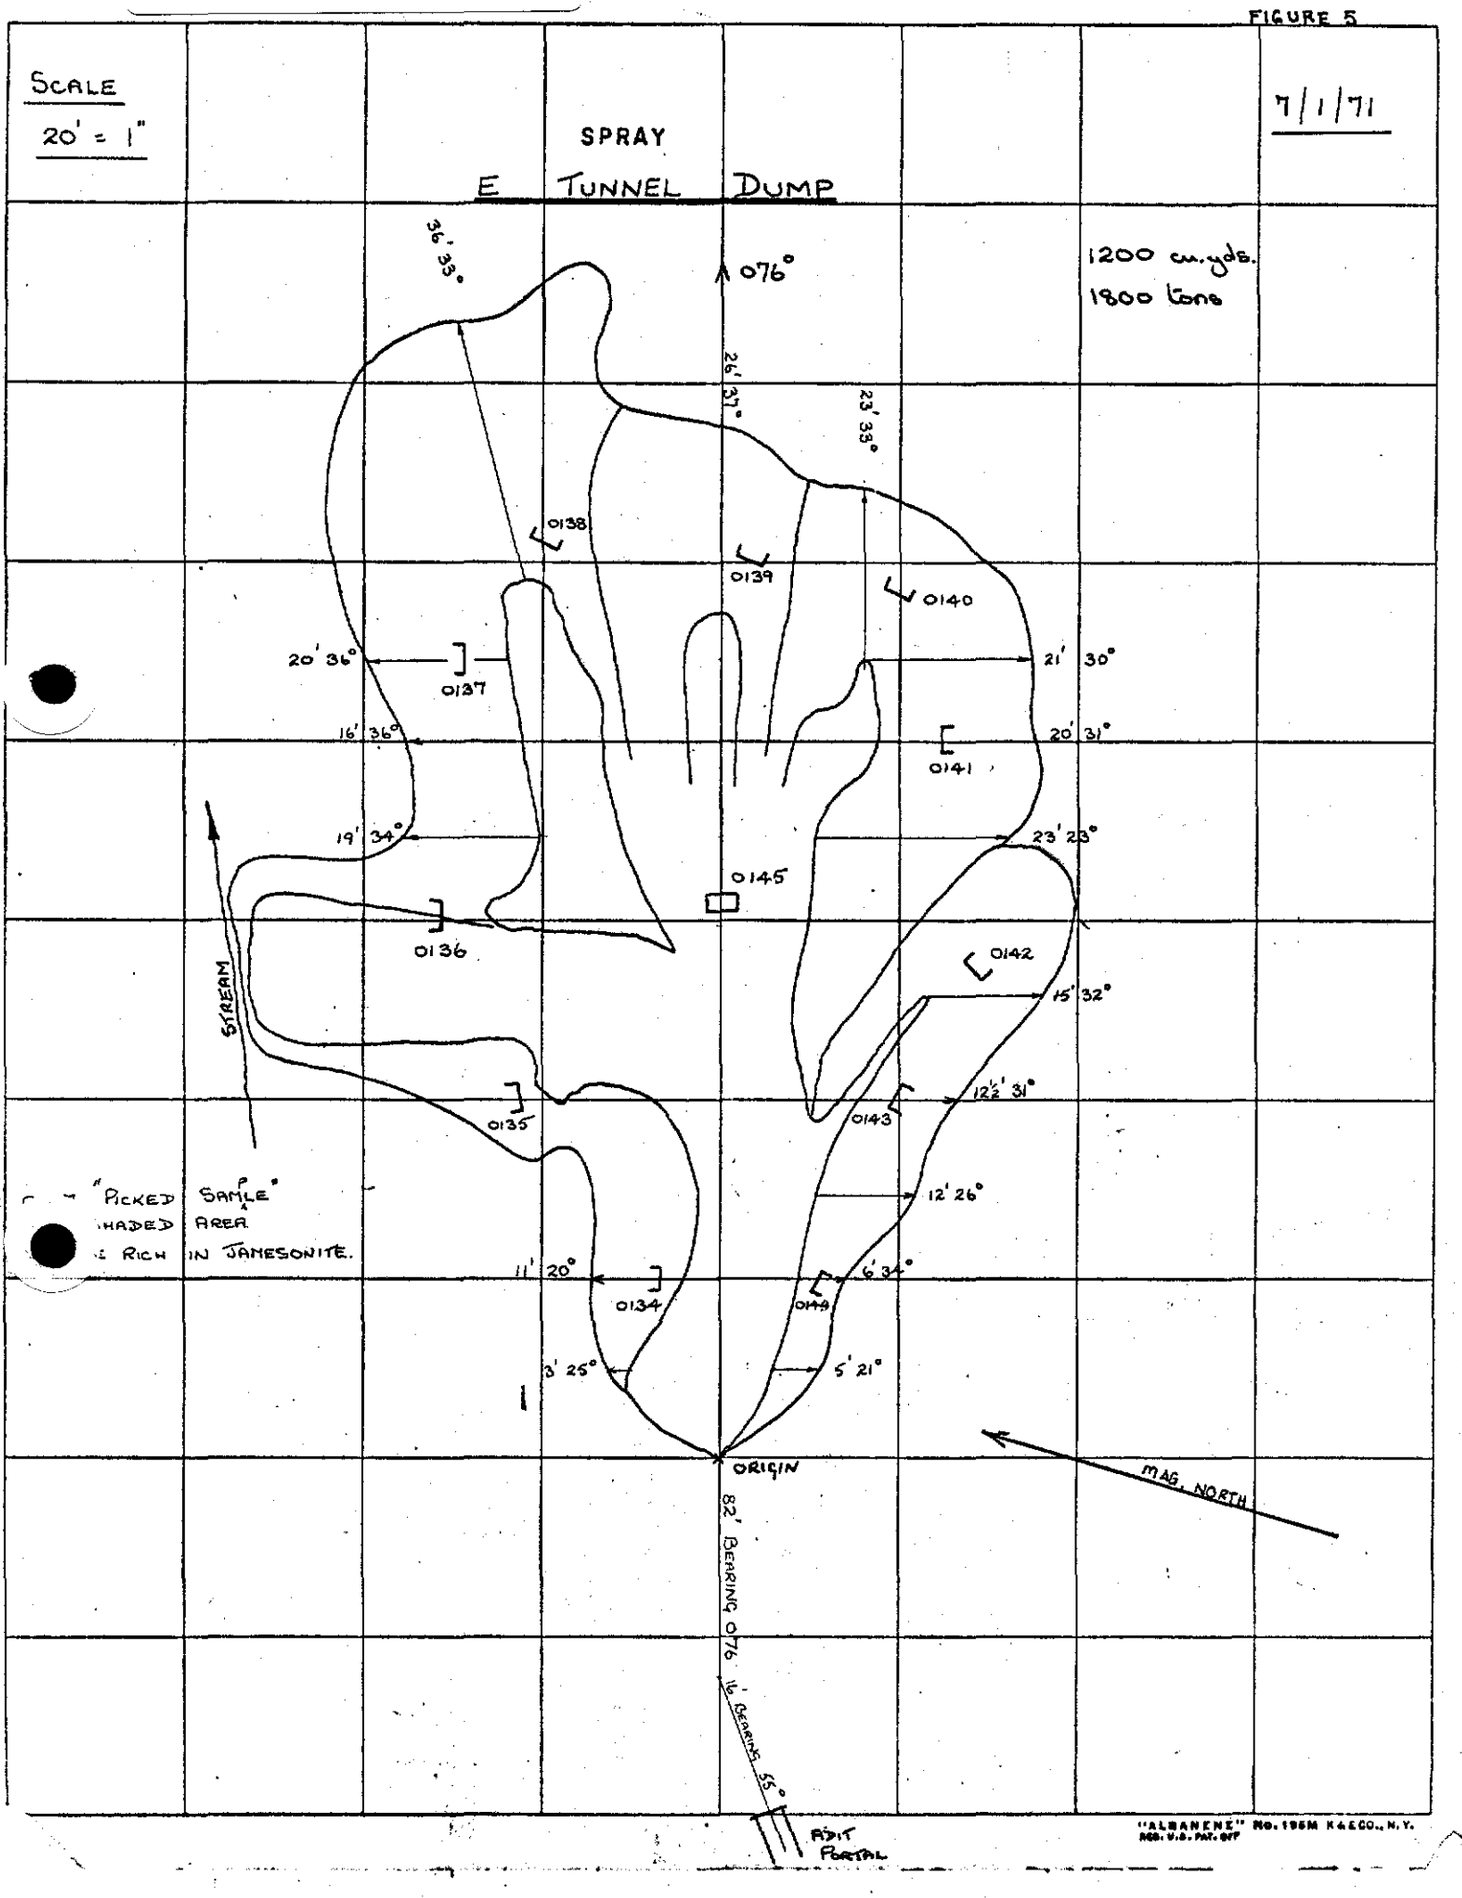

FIGURE 6

SCALE
1" = 20'

SPRAY No. 1 SHAFT (MAIN DUMP)

8/1/71

5 cm

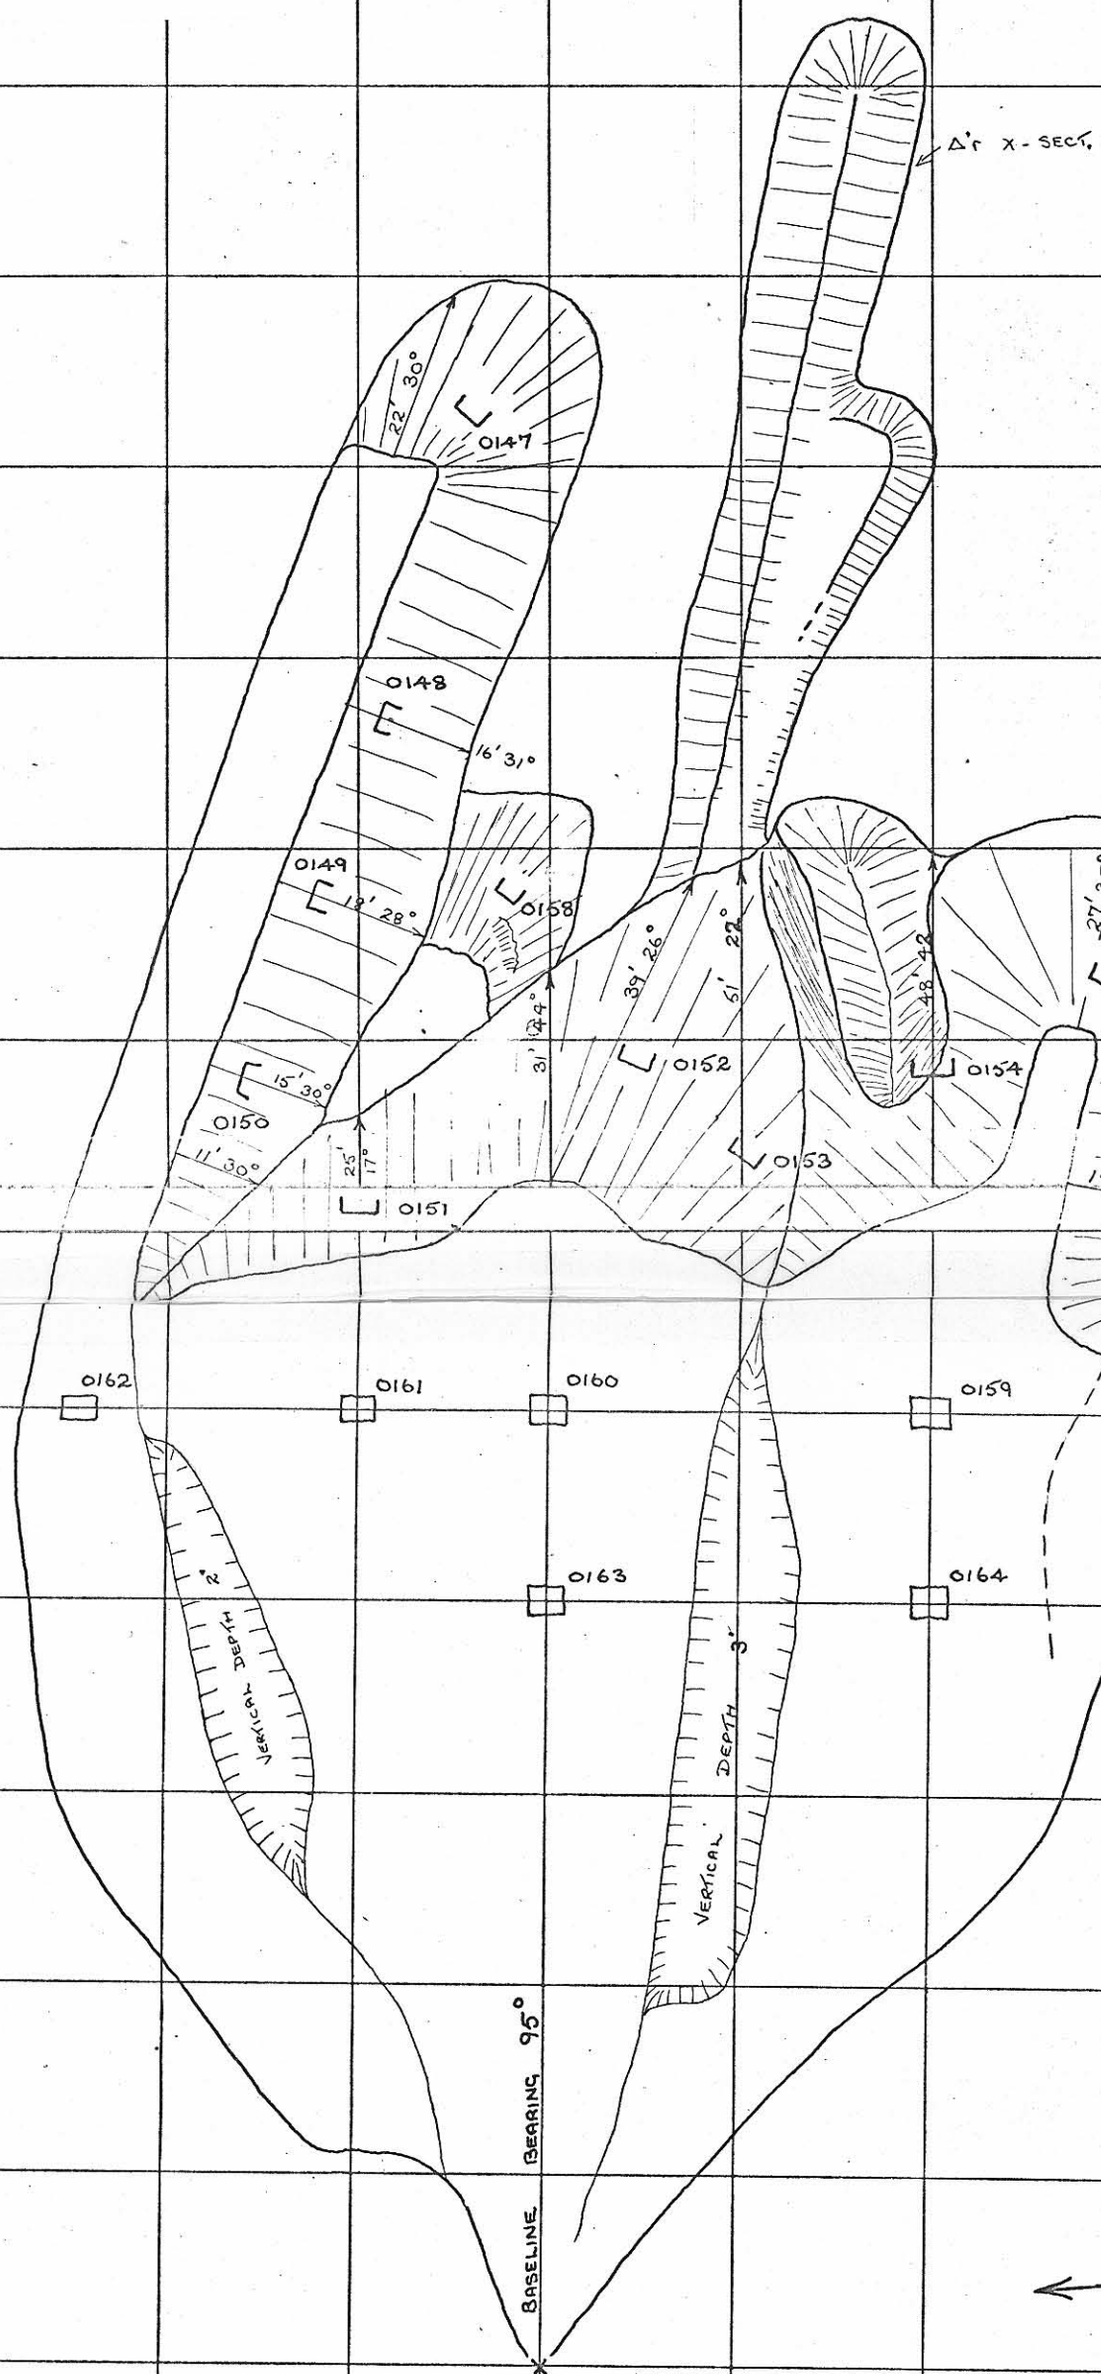

1880 cu.yds.
(mainly shaft mullock)
2800 tons

D.A. 0165 – "PICKED SAMPLE."

SAMPLERS & SURVEYORS
B. HARDY
L. CAIRNS

DRAWN UP BY.
L. Adl Pann

"ALBANENE" No. 196M K&E CO., N.Y. REG. U.S. PAT. OFF

023

835025

024

835026

FIGURE 7

SCALE
1" = 20'

SPRAY No. 1. SHAFT NORTH ADIT DUMP

9/1/71

1150 cu.yds.
1720 tons

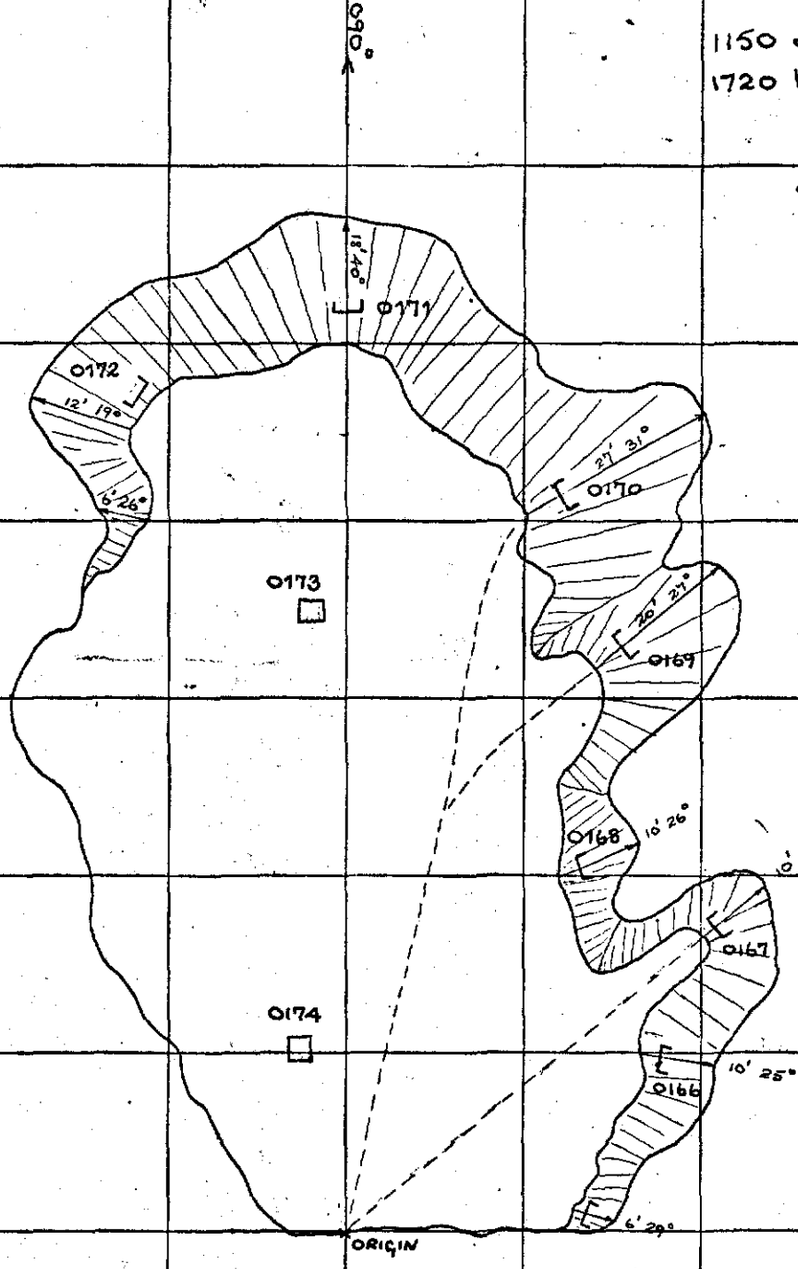

"PICKED SAMPLE"

D.A. 0175

ADIT BEARING 271°, PORTAL 44·5' FROM PEG & 5·5' WIDE

"ALBANENE" No. 1958M KAECO., N.Y.
REG. U.S. PAT. OFF

5 cm

835027

025

SPRAY No 1 SHAFT SOUTH - WEST DUMP

FIGURE 8

SCALE
1" = 20'

11/1/71

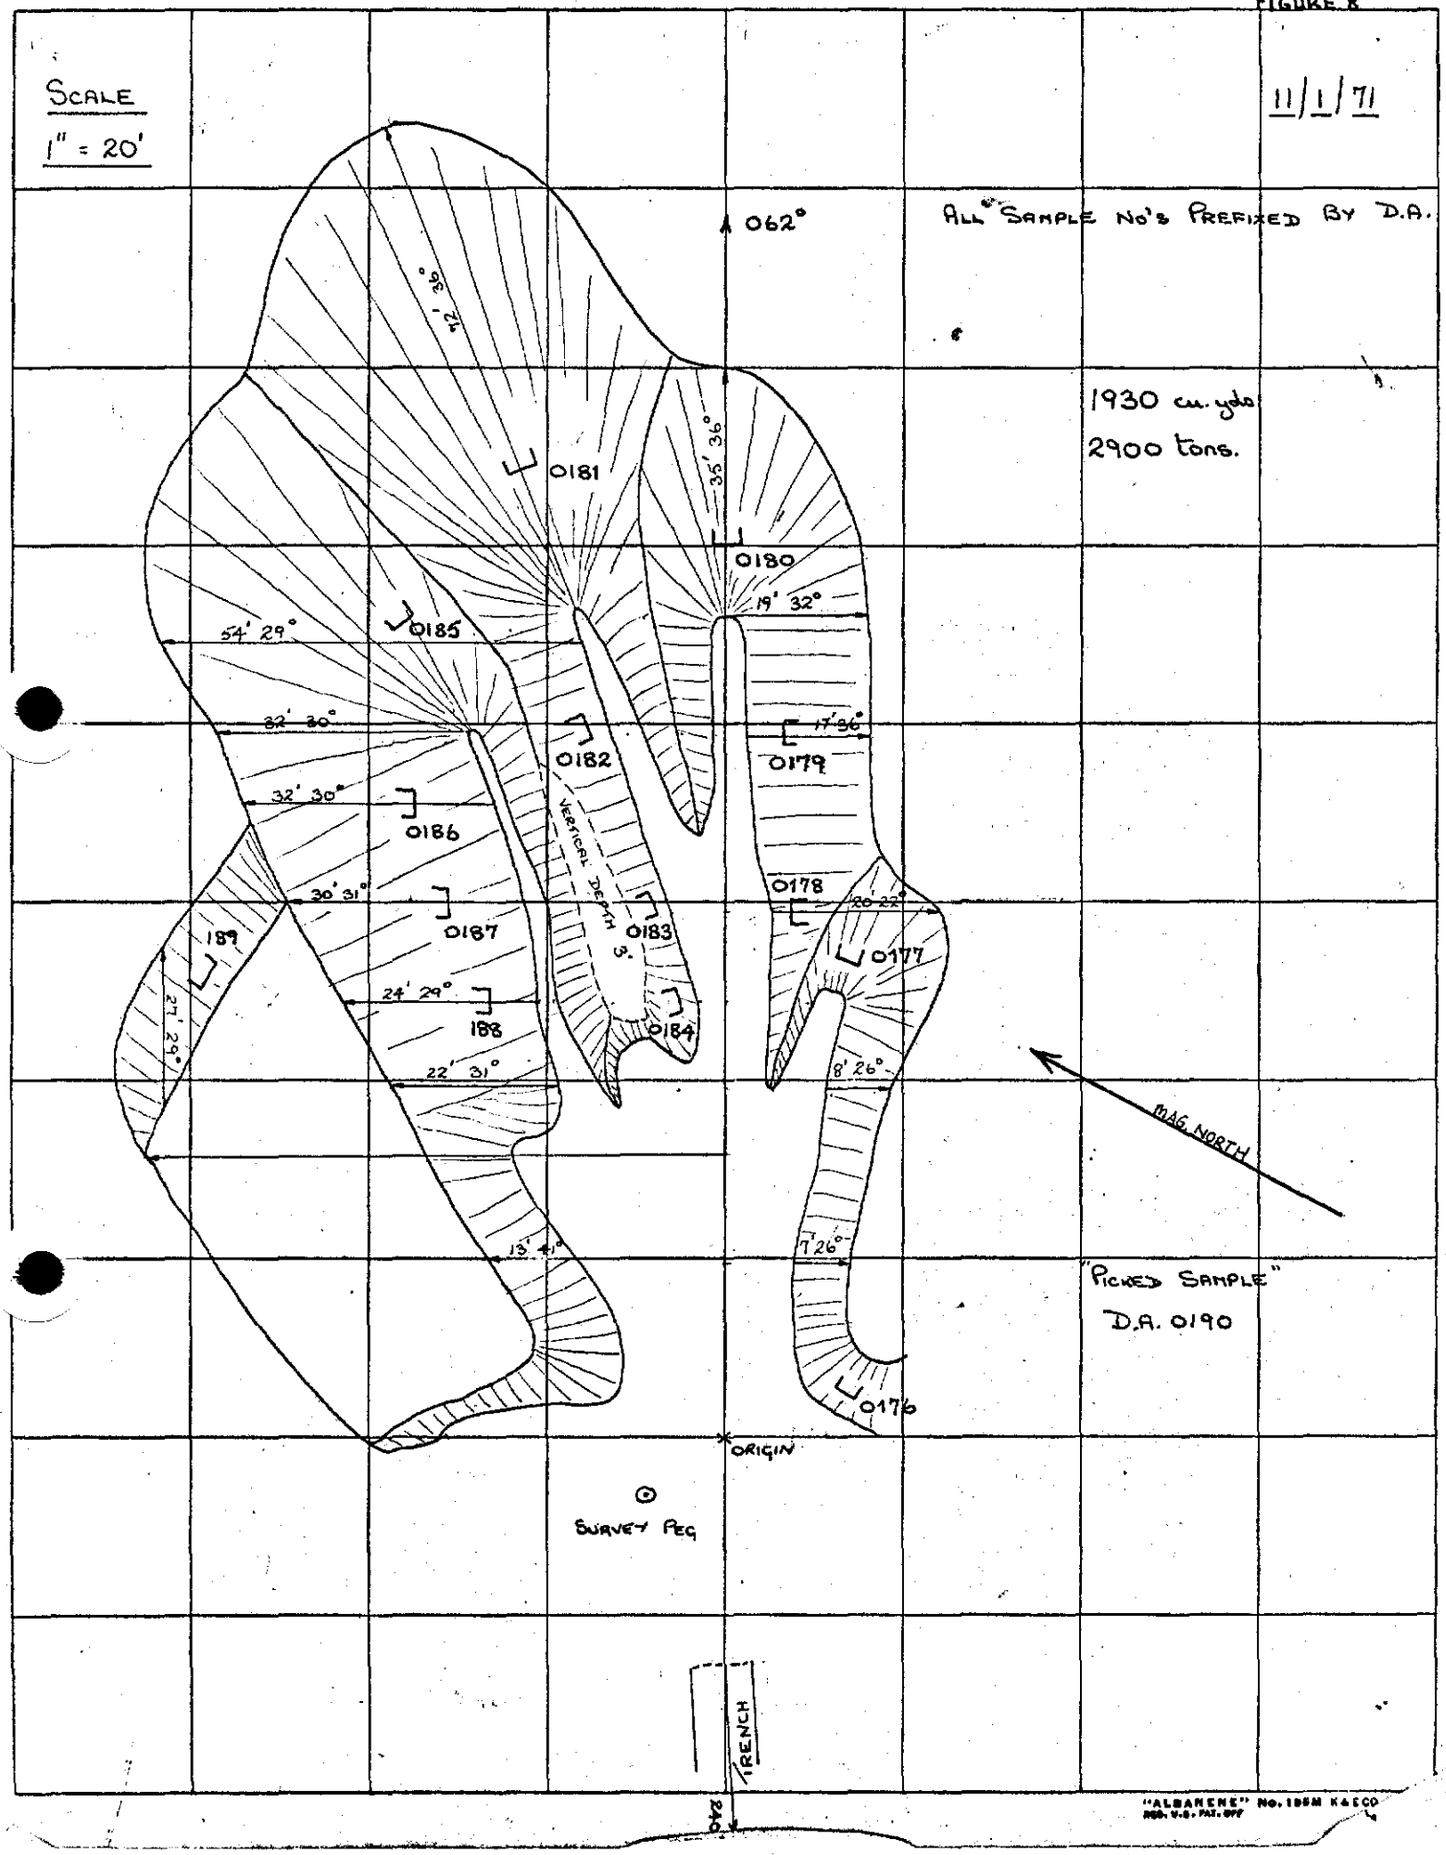

Scale 1" = 20'

835028


SPRAY MINE DUMP

026

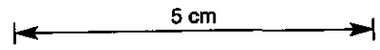

PICKED SAMPLE 0204

1000 cu. yds (approx.)
1500 tons

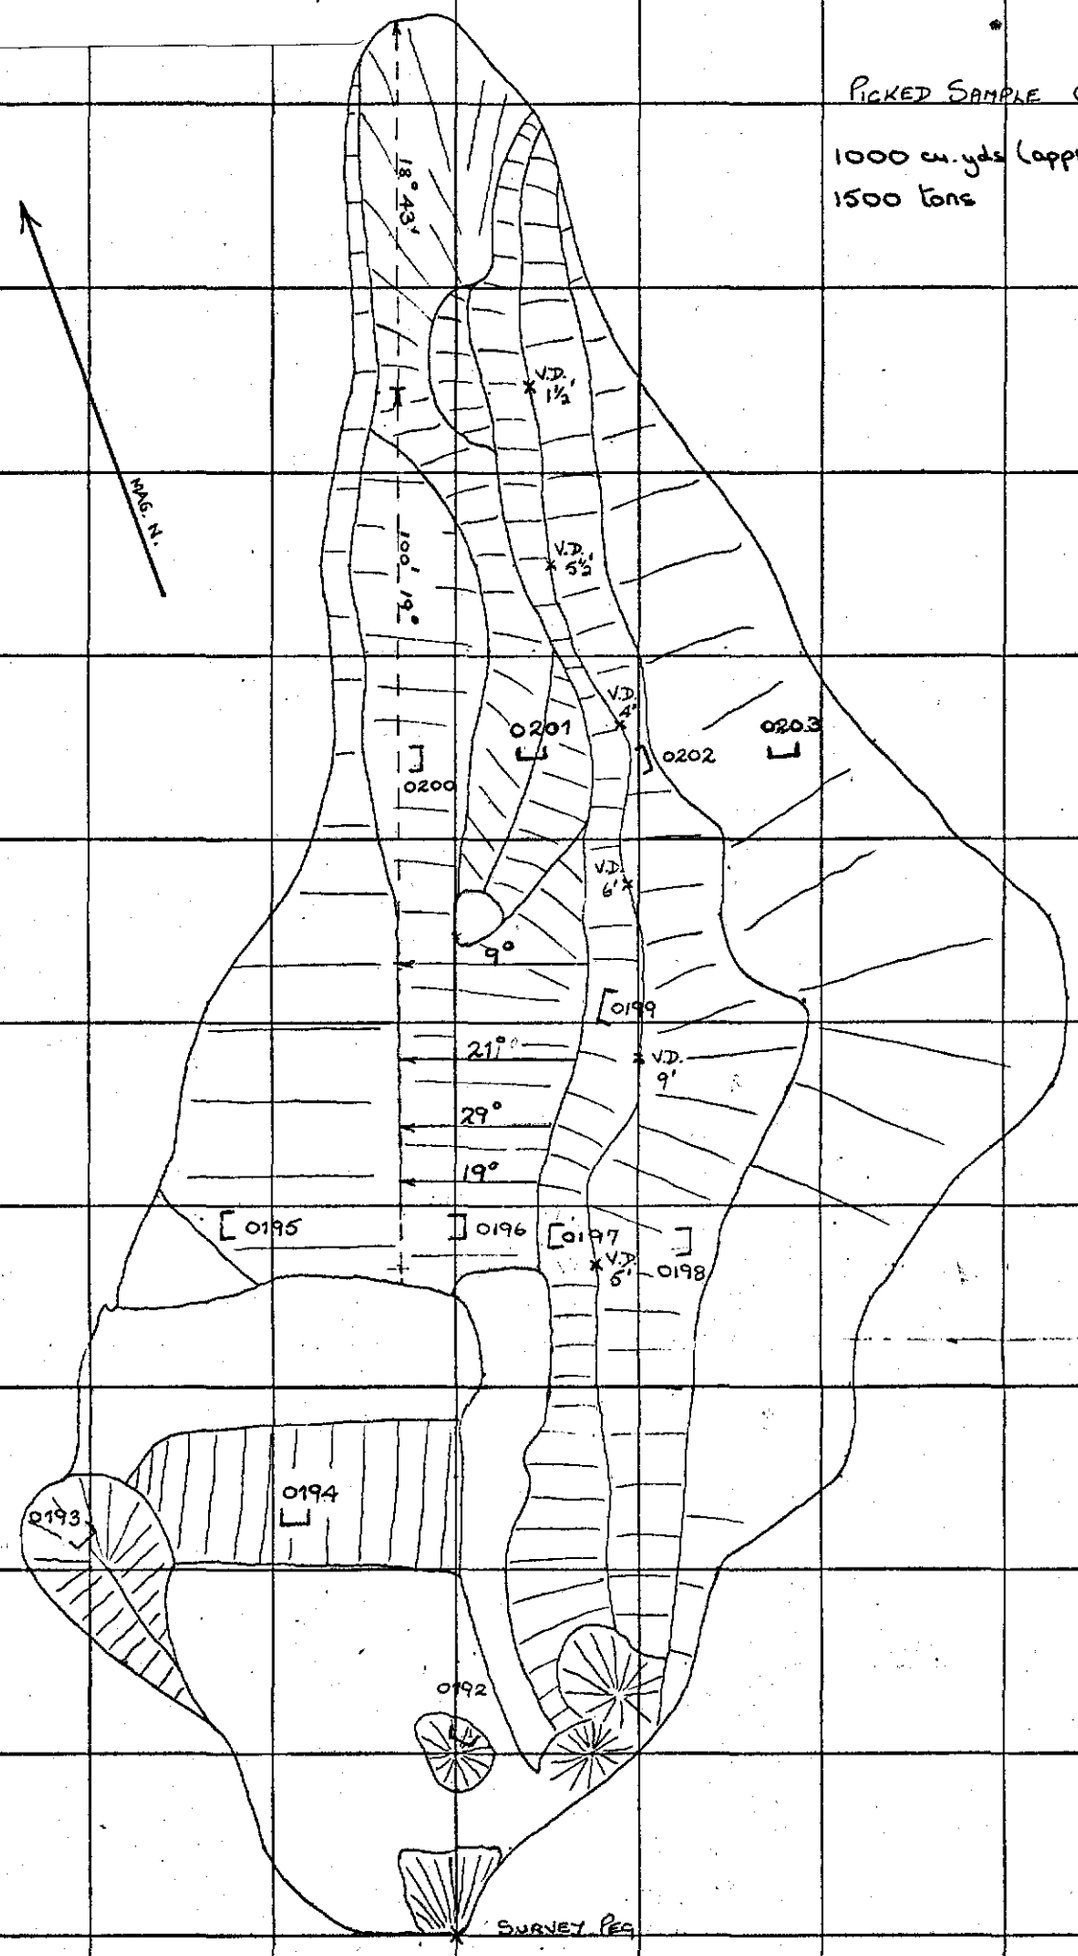

835029

5 cm

SCALE 1" = 20'

SPRAY ADIT DUMP

FIGURE 10

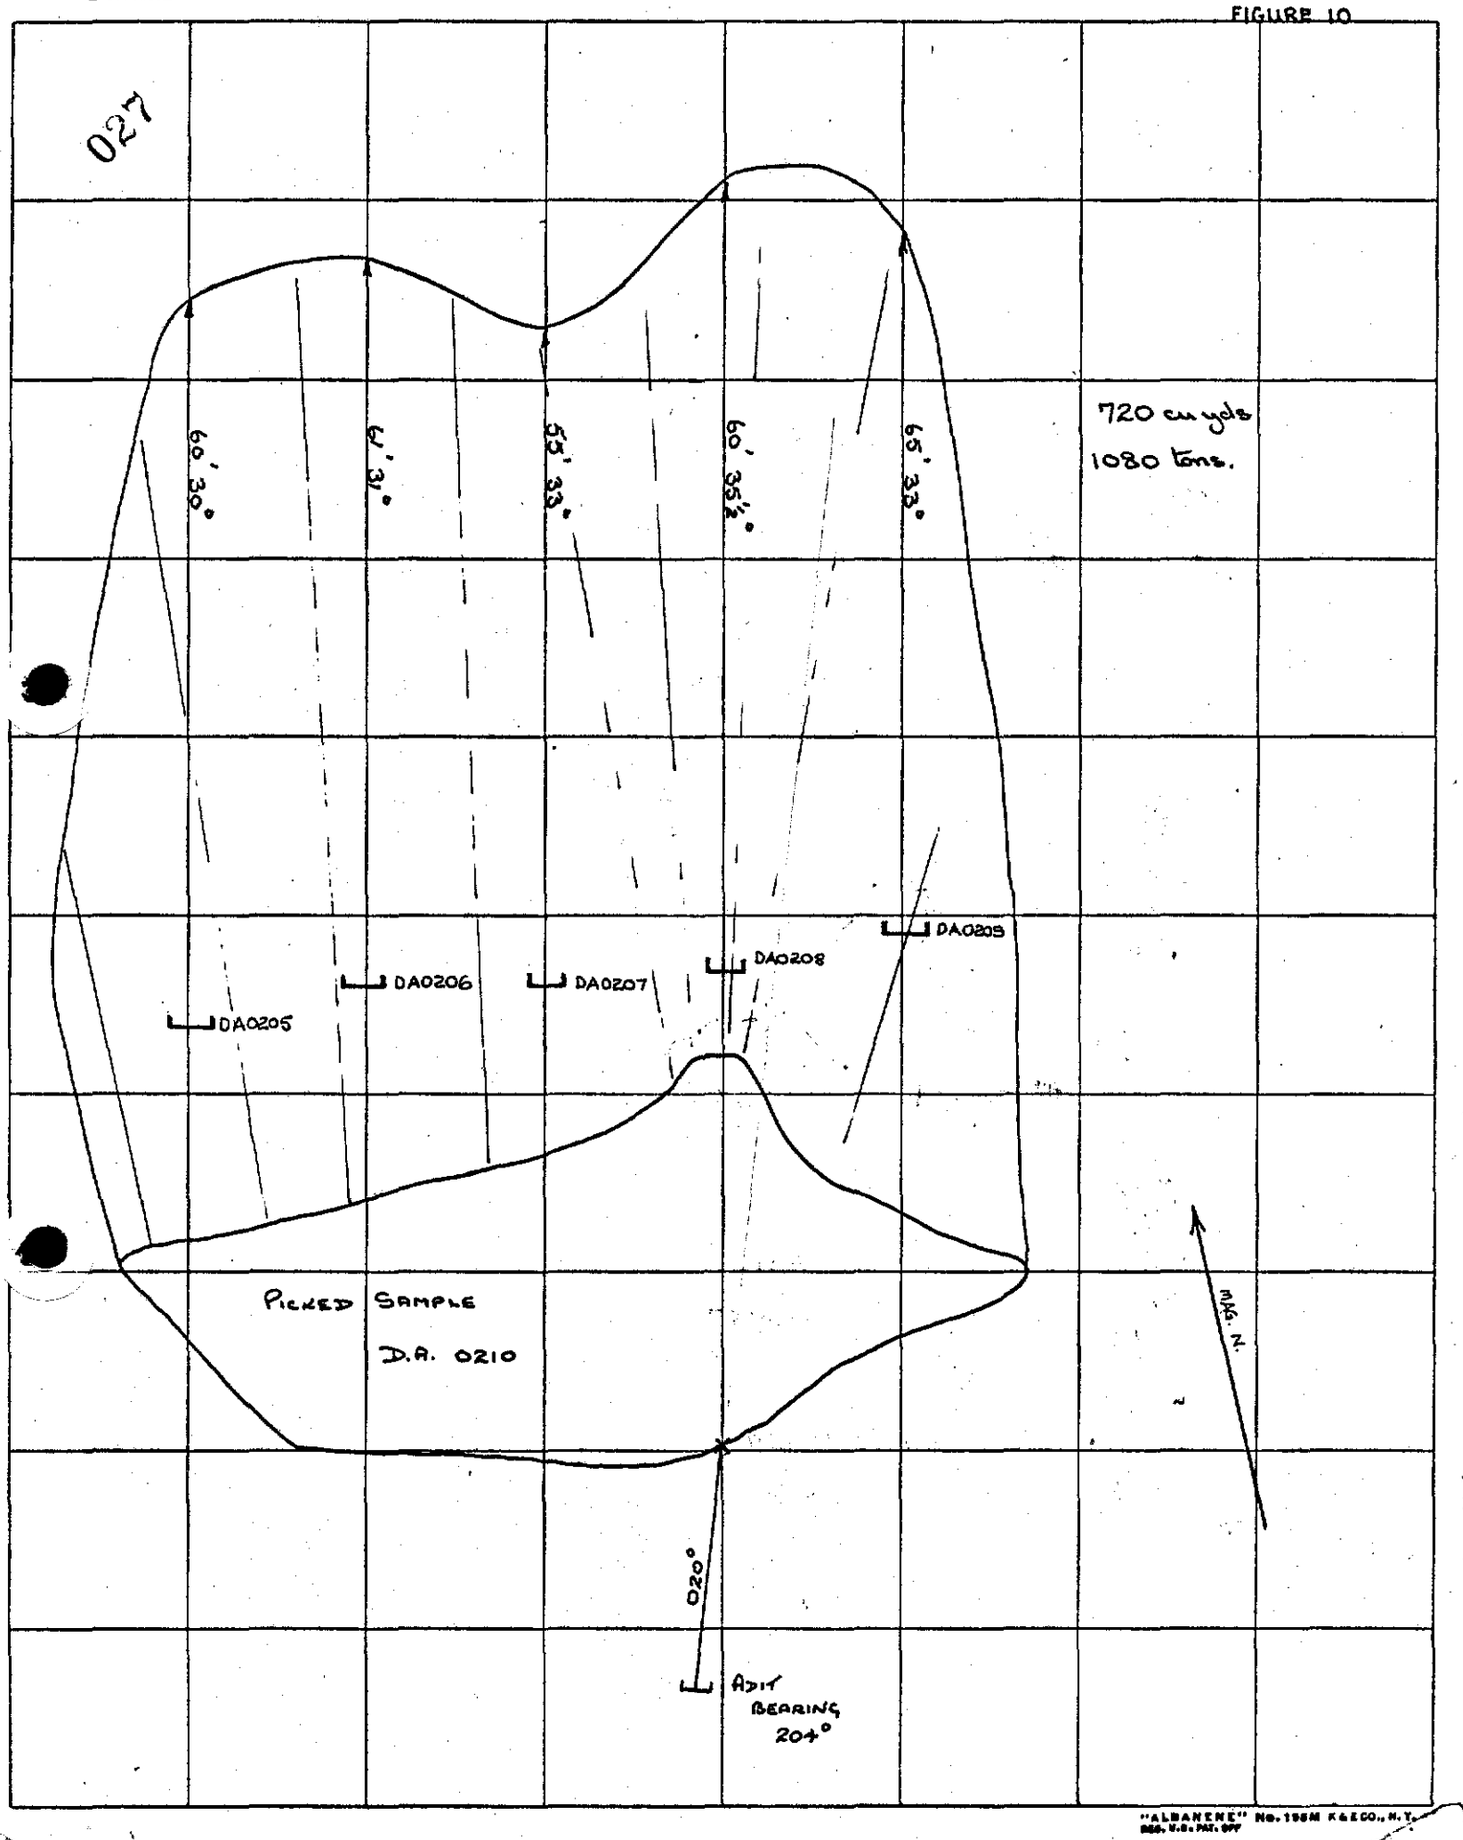

"ALBANENE" No. 195M K&E CO., N.Y.

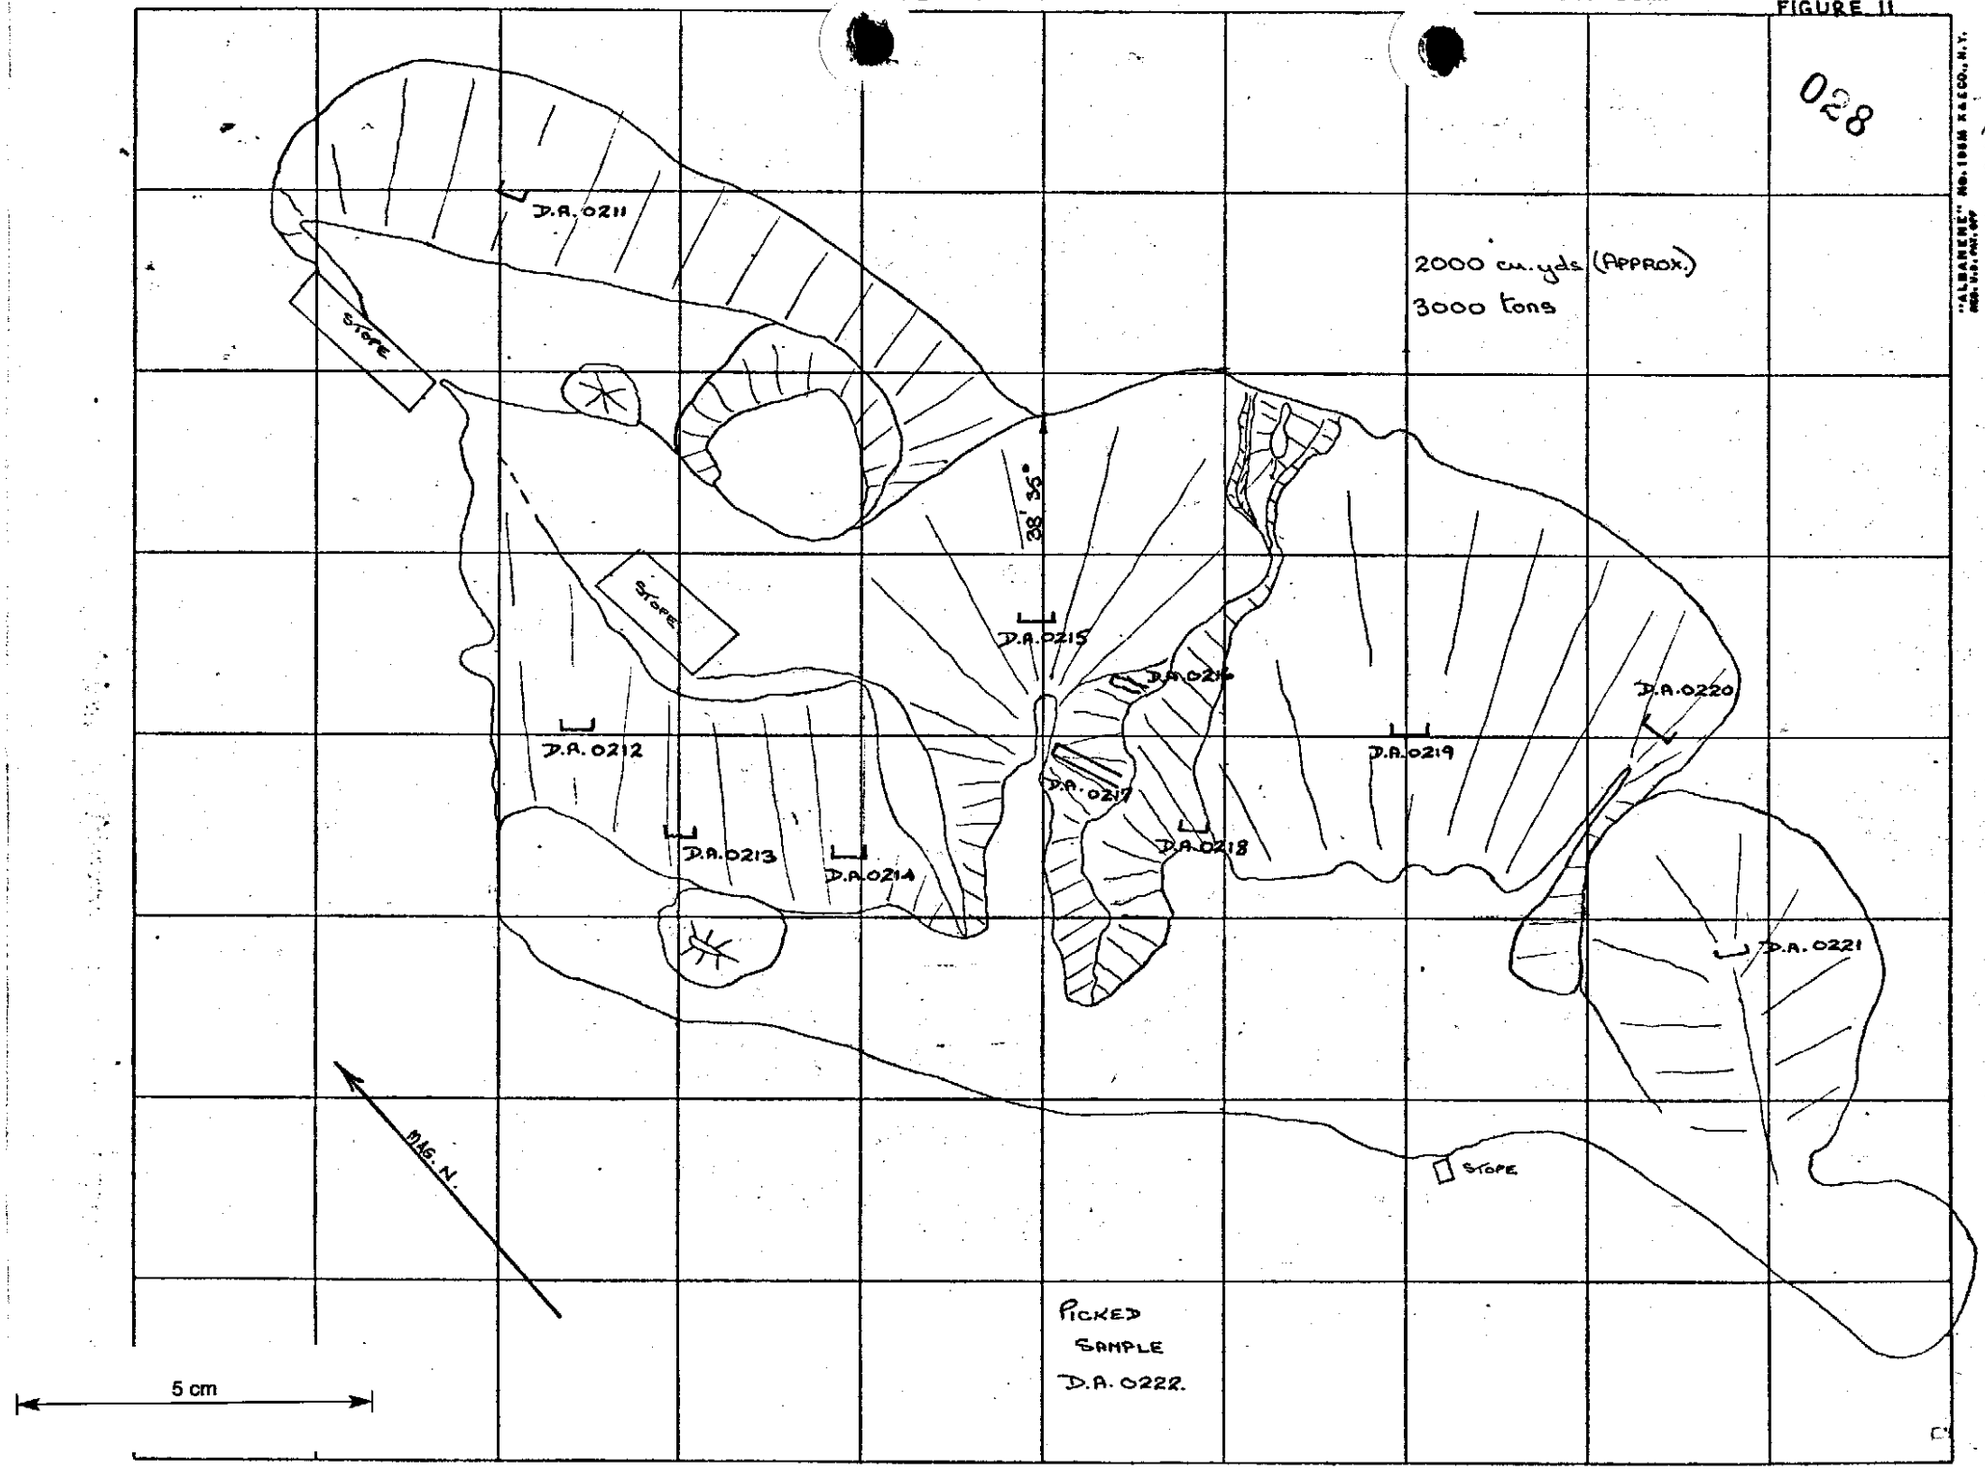

FIGURE 11.

835030

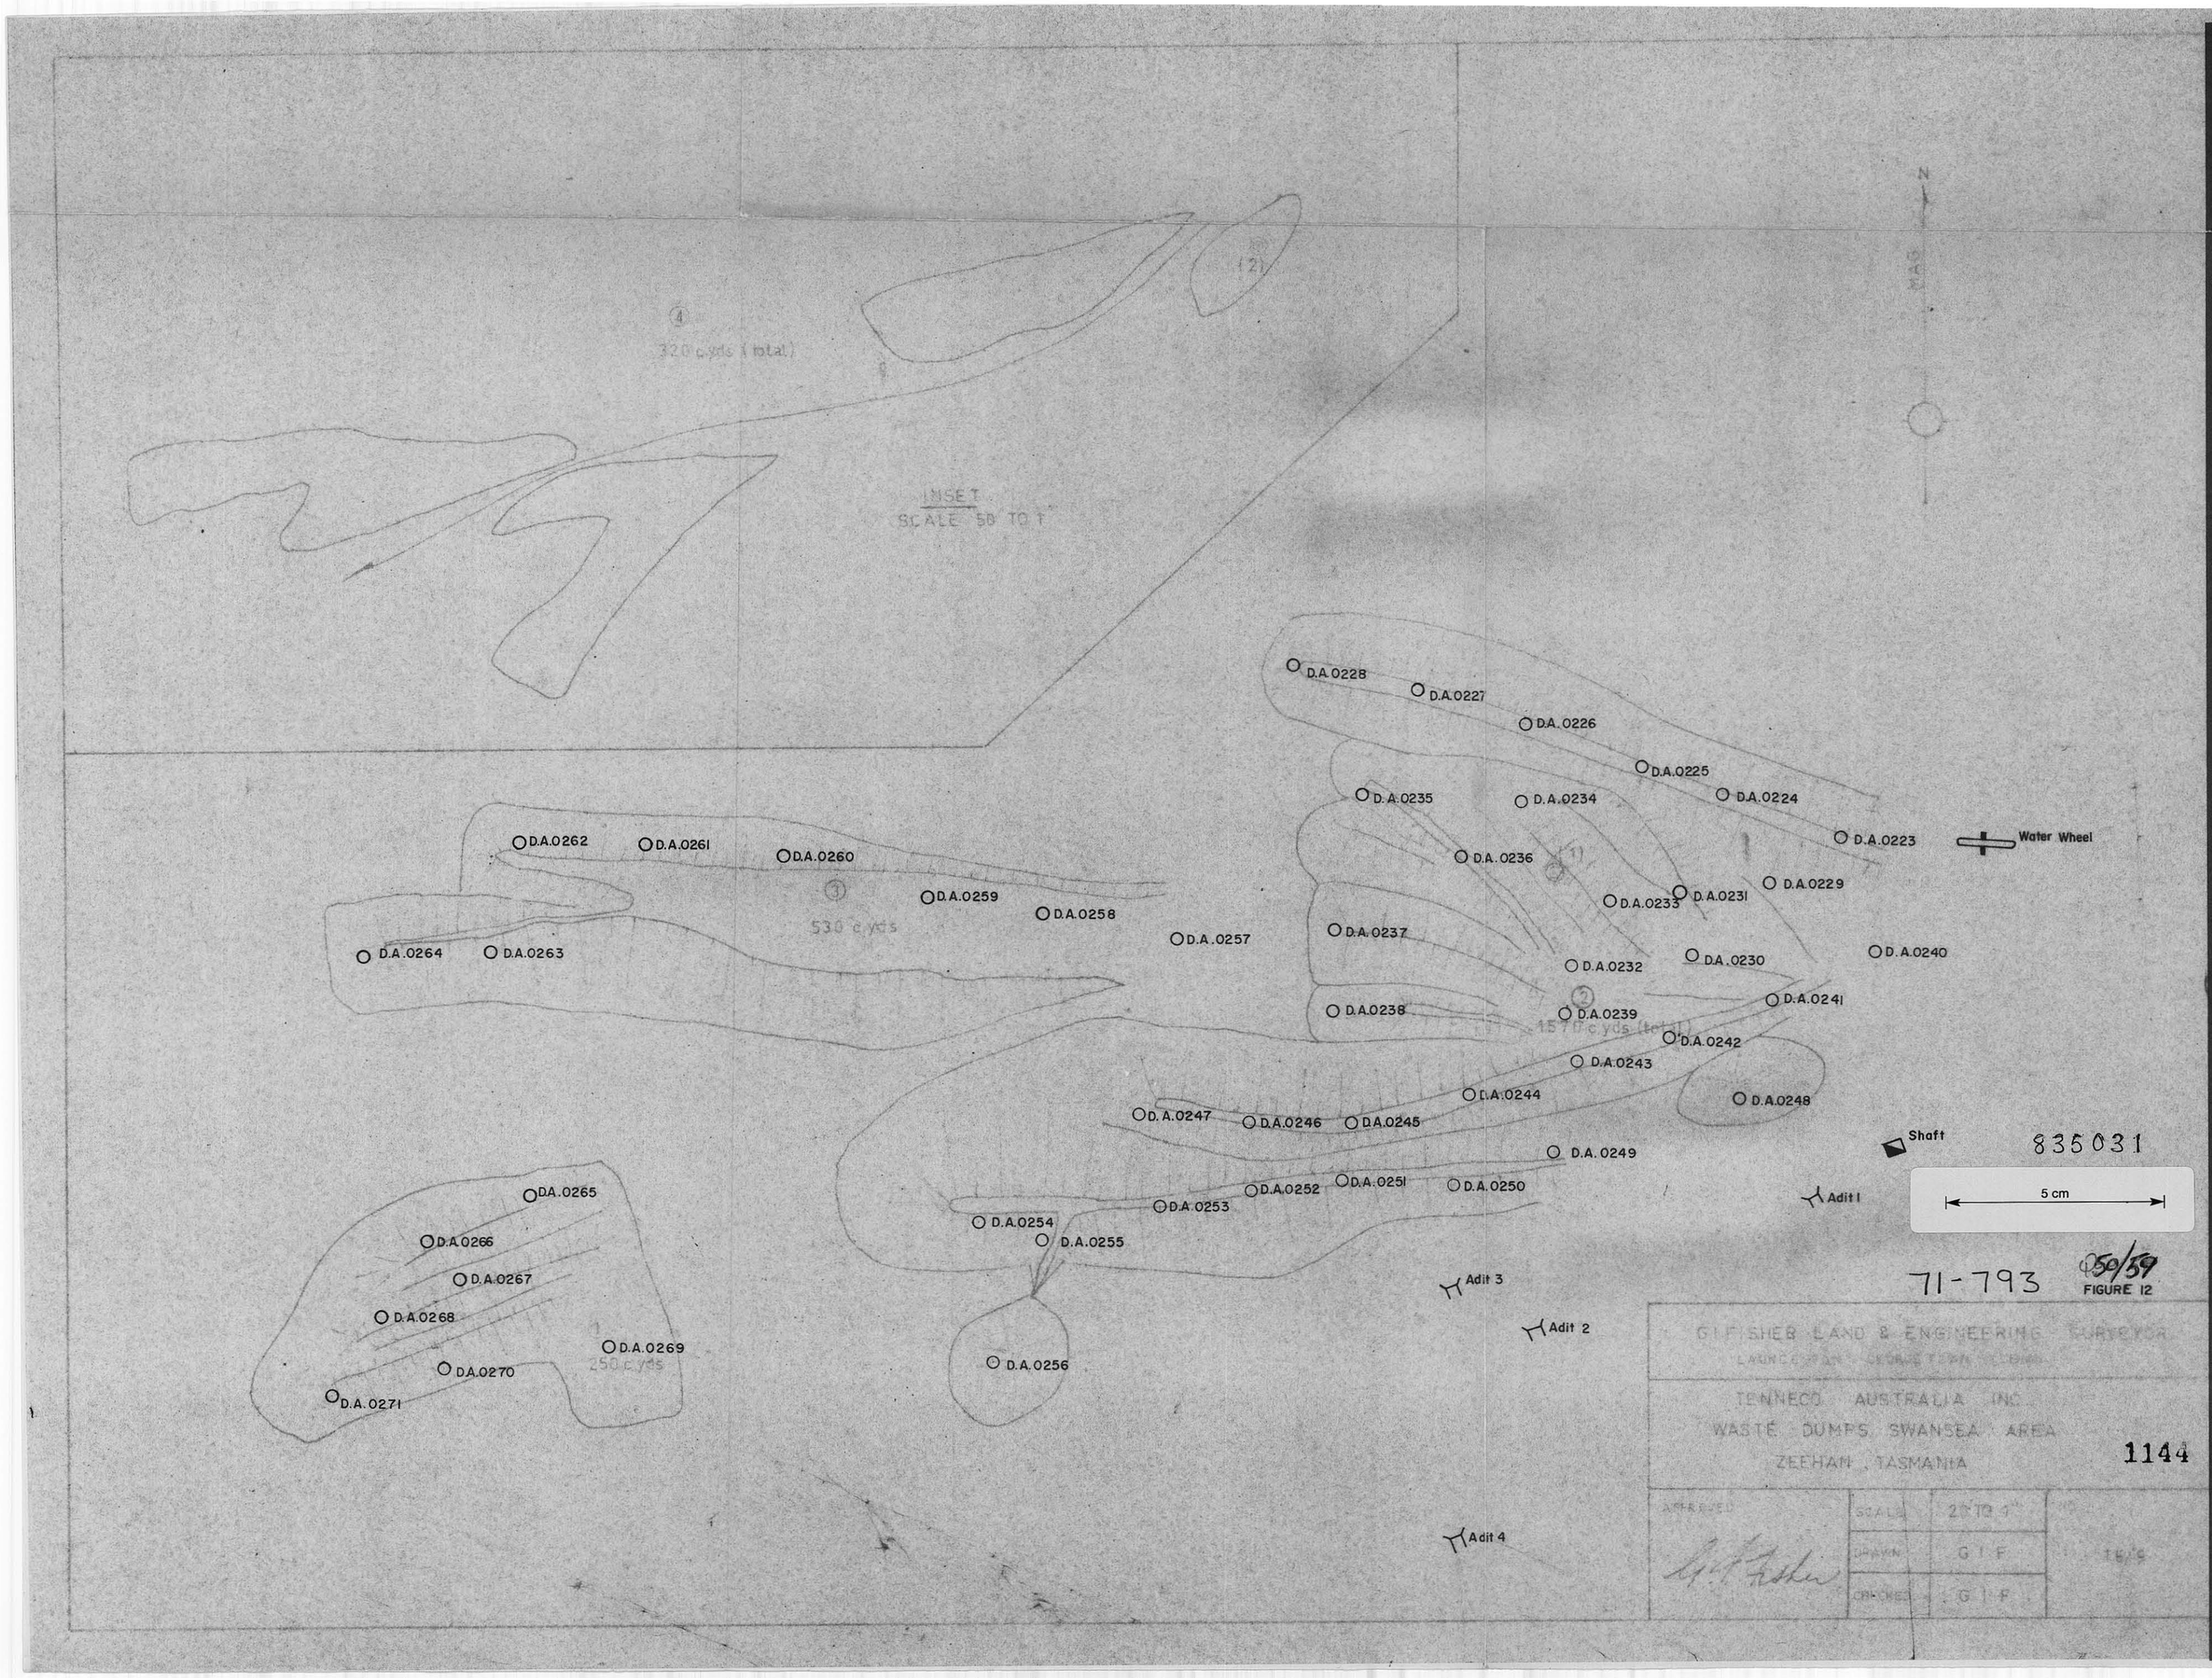

N
MAG
INSET
SCALE 50 TO 1
320 c.yds (total)
530 c.yds
1570 c.yds (total)
250 c.yds
D.A.0228
D.A.0227
D.A.0226
D.A.0225
D.A.0224
D.A.0223
D.A.0235
D.A.0234
D.A.0236
D.A.0233
D.A.0231
D.A.0229
D.A.0237
D.A.0232
D.A.0230
D.A.0240
D.A.0238
D.A.0239
D.A.0241
D.A.0242
D.A.0243
D.A.0244
D.A.0248
D.A.0247
D.A.0246
D.A.0245
D.A.0249
D.A.0252
D.A.0251
D.A.0250
D.A.0253
D.A.0254
D.A.0255
D.A.0256
D.A.0262
D.A.0261
D.A.0260
D.A.0259
D.A.0258
D.A.0257
D.A.0264
D.A.0263
D.A.0265
D.A.0266
D.A.0267
D.A.0268
D.A.0269
D.A.0270
D.A.0271
Water Wheel
Shaft
Adit 1
Adit 2
Adit 3
Adit 4
5 cm
835031
71-793
050/59
FIGURE 12
G.I.FISHER LAND & ENGINEERING SURVEYOR
LAUNCESTON GEORGETOWN
TENNECO AUSTRALIA INC.
WASTE DUMPS SWANSEA AREA
ZEEHAN, TASMANIA
1144
APPROVED
SCALE 20 TO 1
DRAWN G.I.F.
CHECKED G.I.F.
16/9

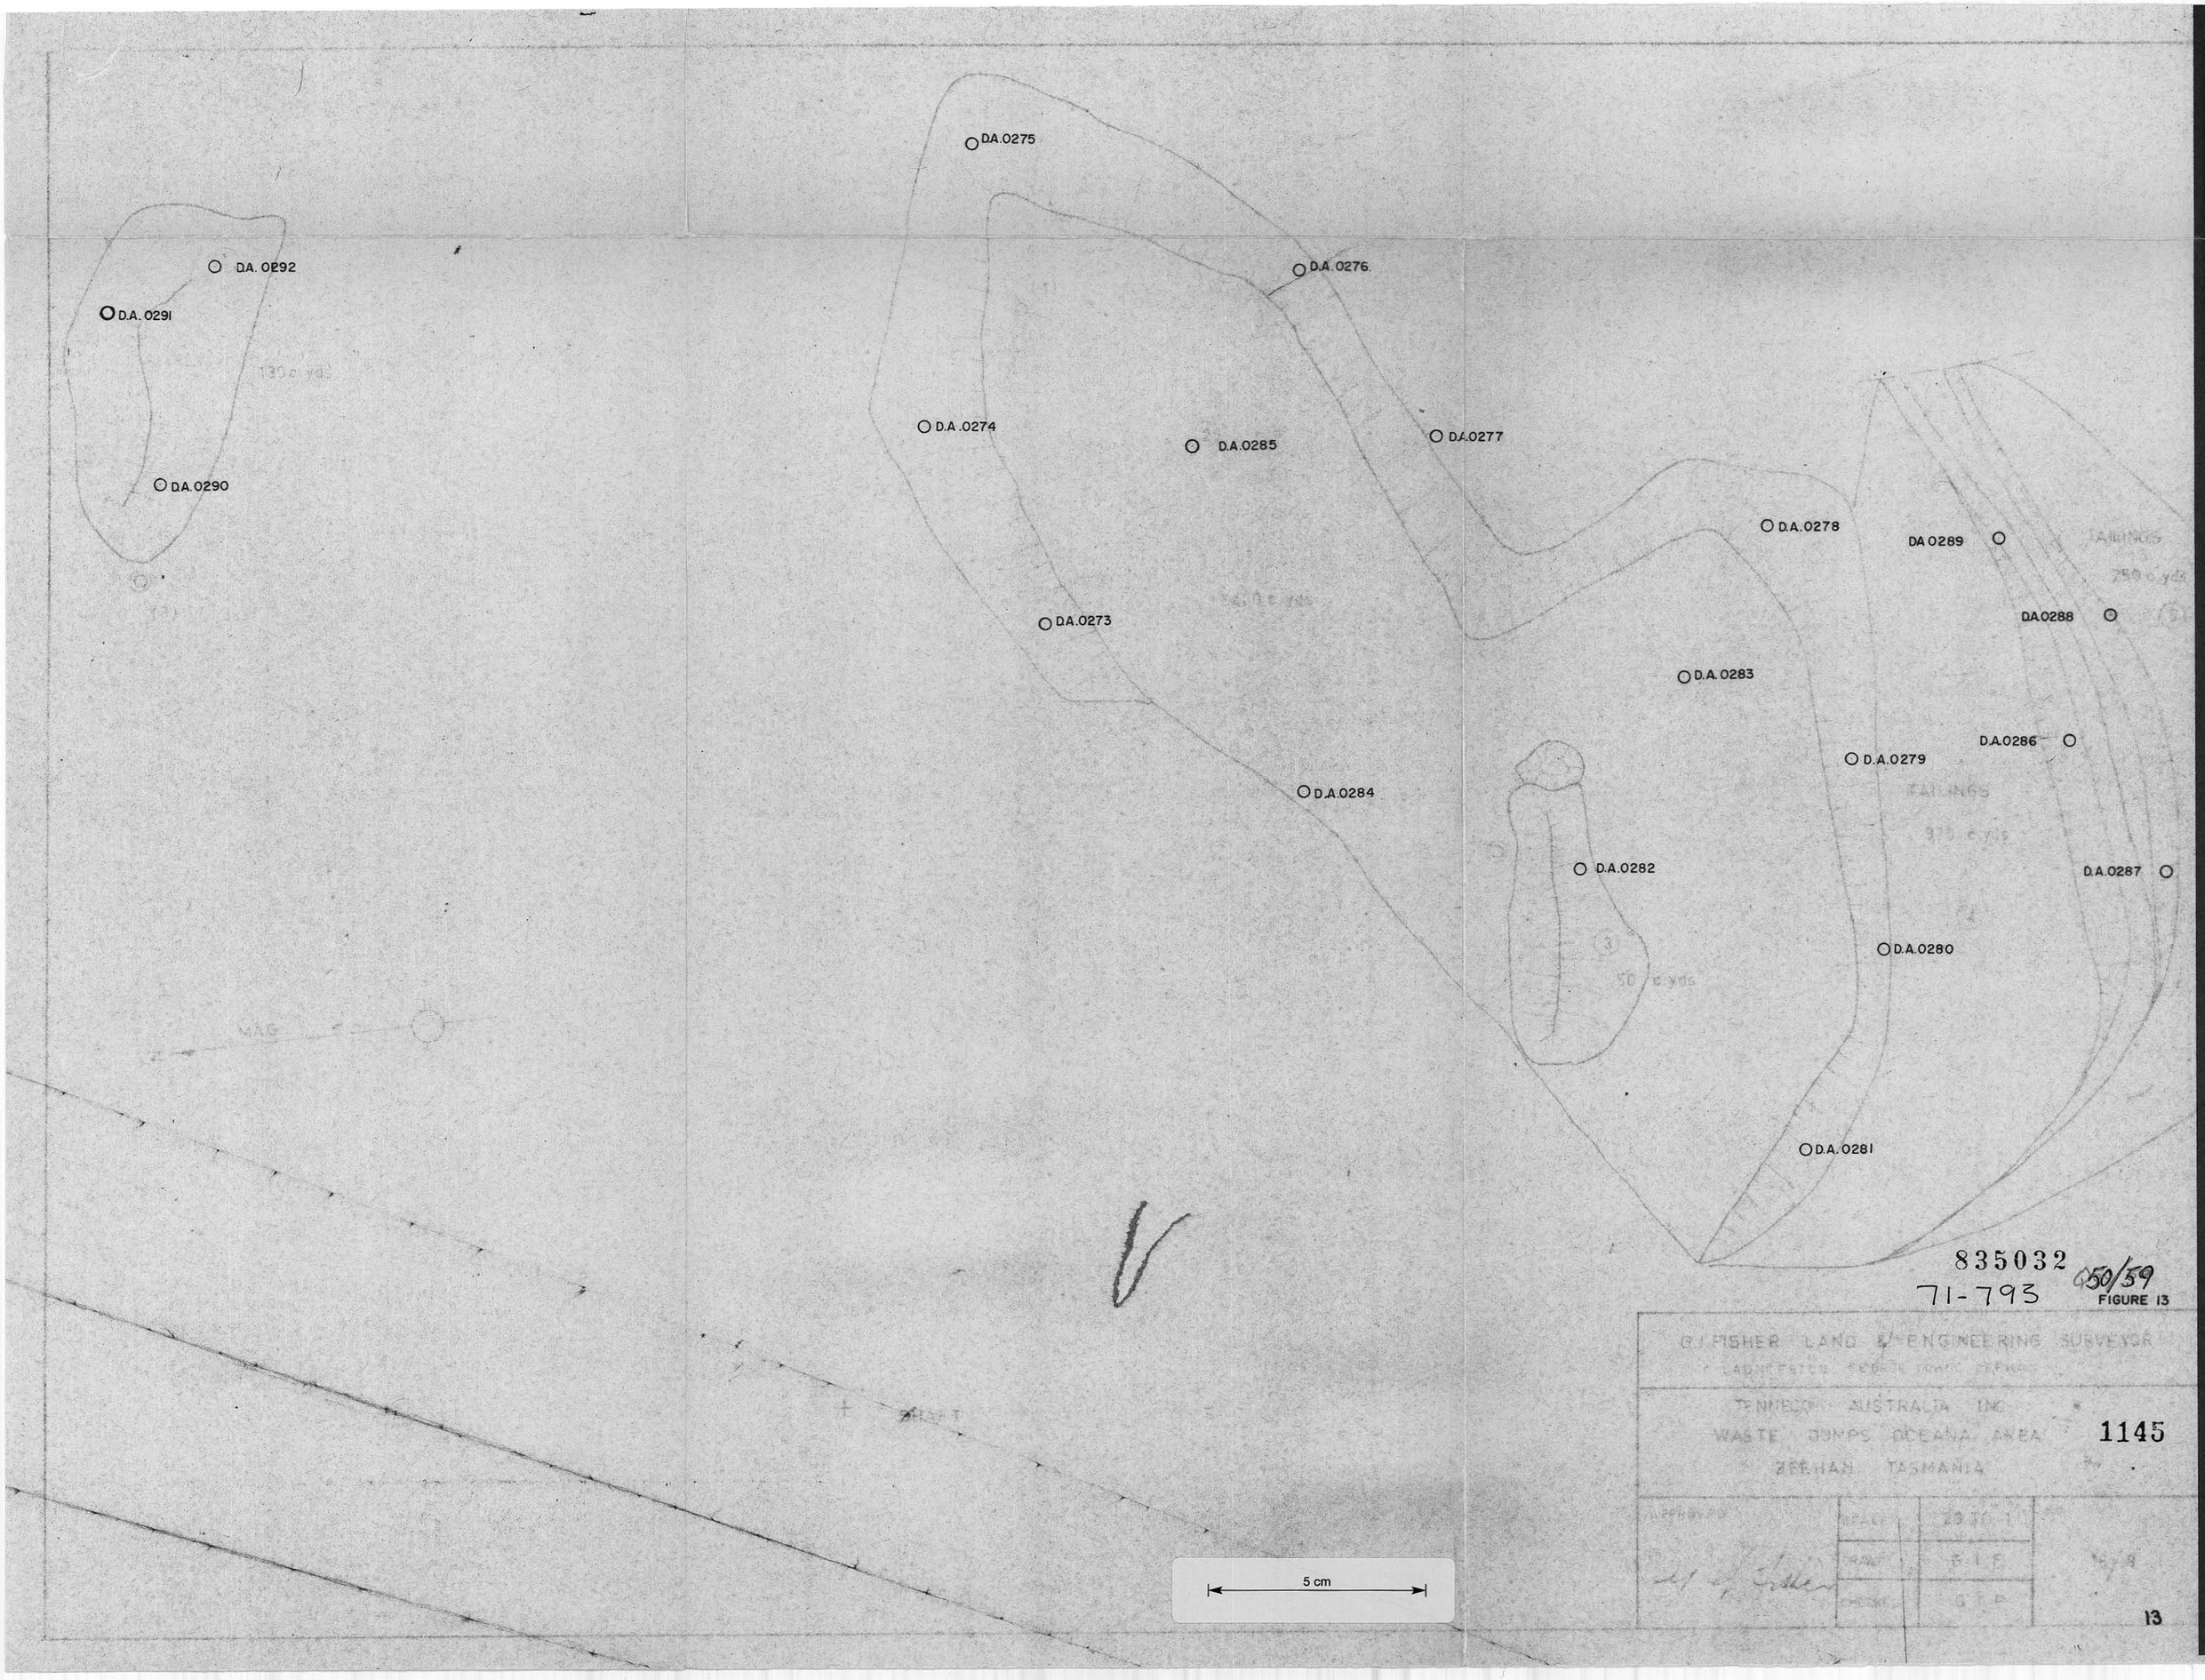

835032
71-793

FIGURE 13

G.J. FISHER LAND & ENGINEERING SURVEYOR
LAUNCESTON TASMANIA

TENNECO AUSTRALIA INC.
WASTE DUMPS OCEANA AREA
ZEEHAN TASMANIA

1145

APPROVED	SCALE	20 30 40
	DRAWN	G.J.F.
	CHECKED	G.J.F.

13

MAG N

D.A.0363 (3)
D.A.0364
D.A.0365
D.A.0366

30 c yds
4
D.A.0367
D.A.0368
D.A.0372
5
D.A.0370
280 c yds
D.A.0371
D.A.0369

D.A.0332
D.A.0331
D.A.0351
D.A.0352
± 4000 c yds
1
D.A.0353
D.A.0349
D.A.0348
D.A.0347
D.A.0344
D.A.0343
D.A.0342
D.A.0341
D.A.0340
D.A.0339
D.A.0338
D.A.0324
D.A.0327
D.A.0323
Channel Sample D.A.0326
D.A.0330
D.A.0328
Small Adit Approx. direction of drive
D.A.0321
D.A.0322
Channel Sample D.A.0325
D.A.0362
D.A.0361
D.A.0360
D.A.0334
D.A.0333
D.A.0335
D.A.0354
D.A.0345
D.A.0346
Water Race
2
D.A.0314
D.A.0312
D.A.0310
D.A.0316
D.A.0317
Channel Sample D.A.0318
D.A.0315
Channel Sample D.A.0320
D.A.0337
D.A.0336
D.A.0308
D.A.0306
D.A.0293
D.A.0300
(1)
D.A.0302
± 12000 c yds (total)
D.A.0296
D.A.0315
D.A.0294
D.A.0303
D.A.0301
D.A.0305
D.A.0233
D.A.0295
D.A.0307
D.A.0303
D.A.0309
D.A.0311
D.A.0304
D.A.0297
D.A.0355
D.A.0351
D.A.0357
D.A.0358
D.A.0359
3
1200 c yds

835033
5 cm

71-793
Q50/69
FIGURE 14

G. I. FISHER, LAND & ENGINEERING SURVEYOR

TENNECO AUSTRALIA INC
WASTE DUMPS "WESTERN" AREA
ZEEHAN, TASMANIA

1146

SIGNED: G. I. Fisher, REGISTERED SURVEYOR	SCALE	20" TO 1"	NO. 16/6
	DRAWN	G. I. F.	
	CHECKED	G. I. F.	

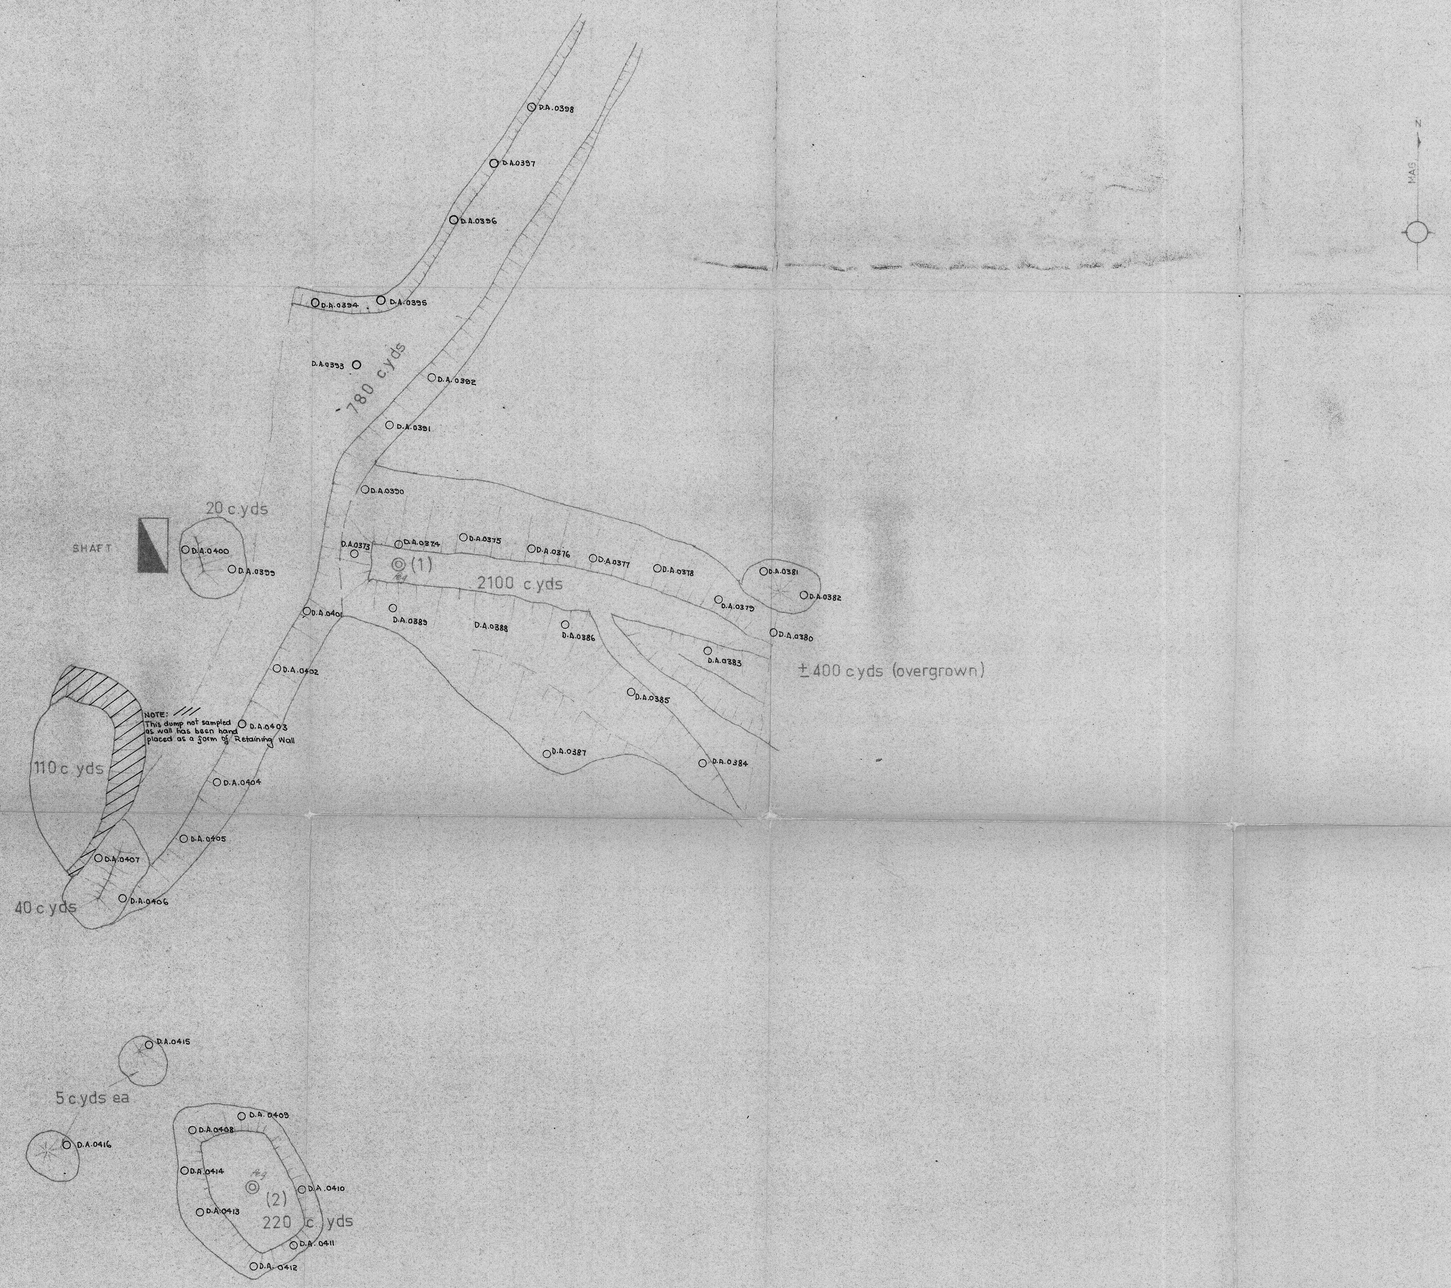

835034

5 cm

71-793

Q50/59

FIGURE 15

G I FISHER, LAND & ENGINEERING SURVEYOR

TENNECO AUSTRALIA INC
WASTE DUMPS, SILVER CROWN AREA
ZEEHAN, TASMANIA

1147

SIGNED	SCALE	20 TO 1	NO
G I Fisher	DRAWN	G I F	16/5
REGISTERED SURVEYOR	CHECKED	G I F	

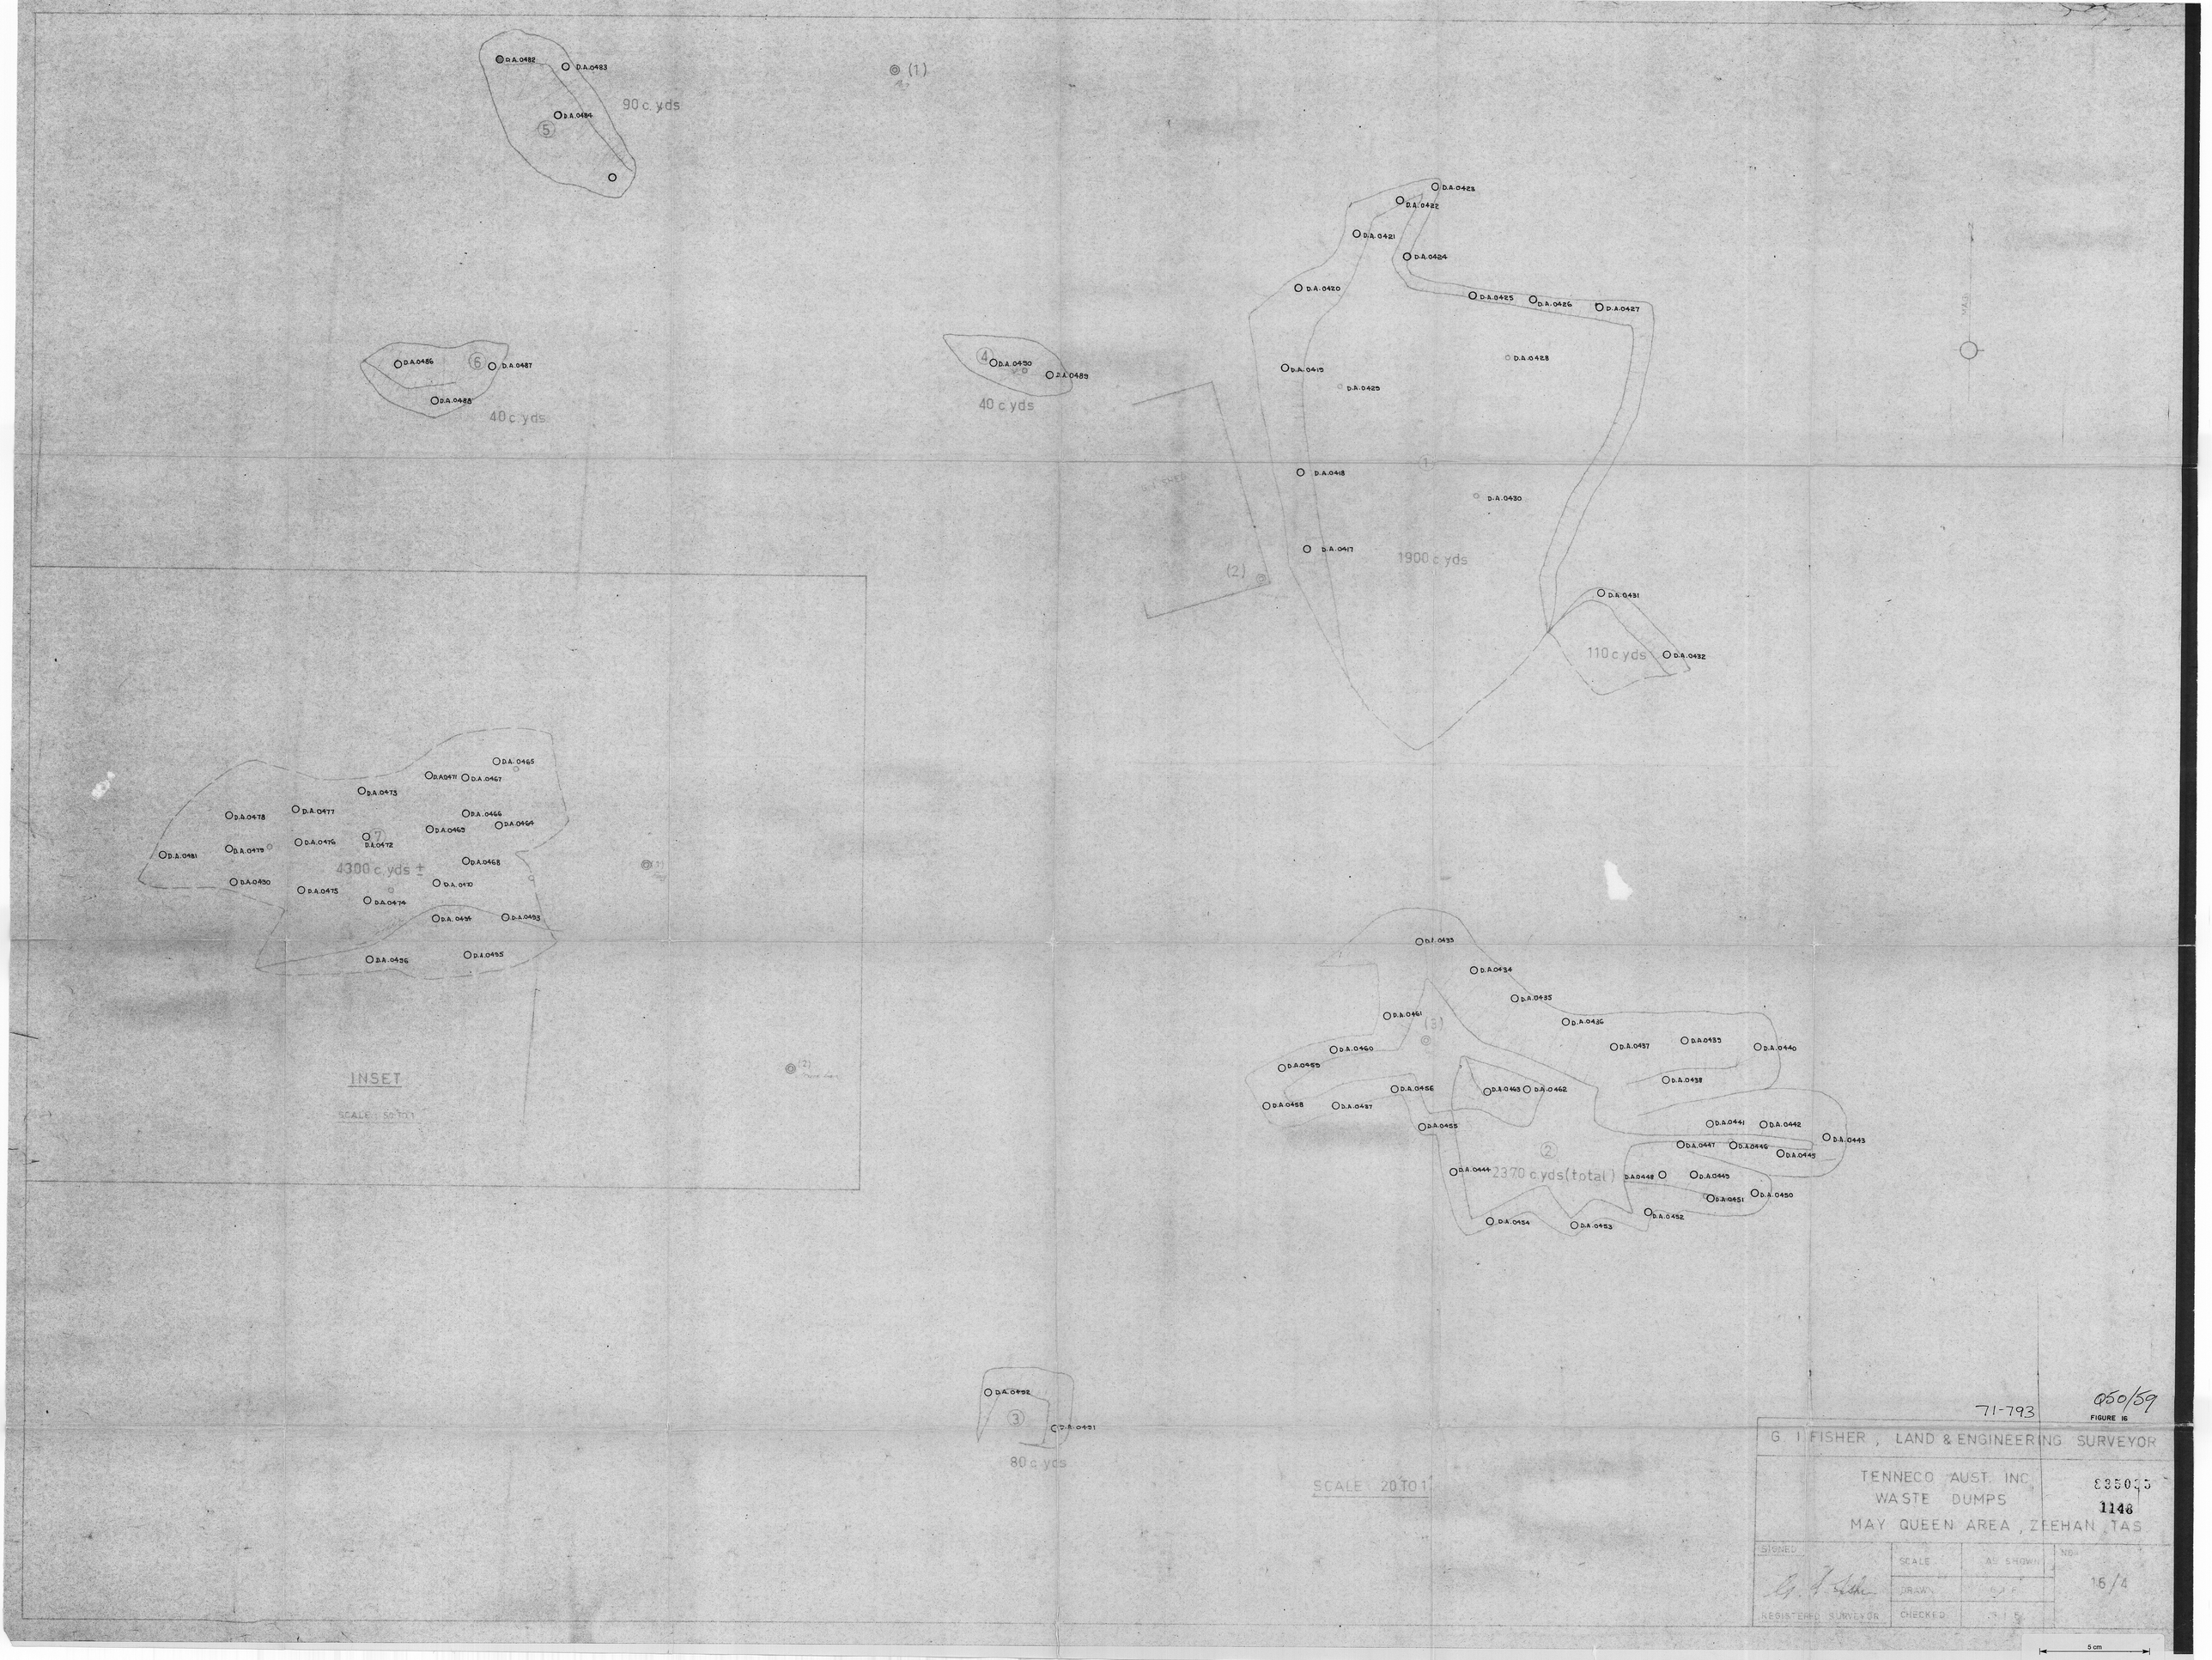

90 c. yds
40 c. yds
40 c. yds
1900 c. yds
110 c. yds
4300 c. yds ±
INSET
2370 c. yds (total)
80 c. yds
SCALE 20 TO 1
71-793
Q50/59
FIGURE 16
G. I. FISHER, LAND & ENGINEERING SURVEYOR
TENNECO AUST. INC.
WASTE DUMPS
MAY QUEEN AREA, ZEEHAN, TAS.
835035
1148
SIGNED
REGISTERED SURVEYOR
SCALE AS SHOWN
DRAWN
CHECKED
NO. 16/4

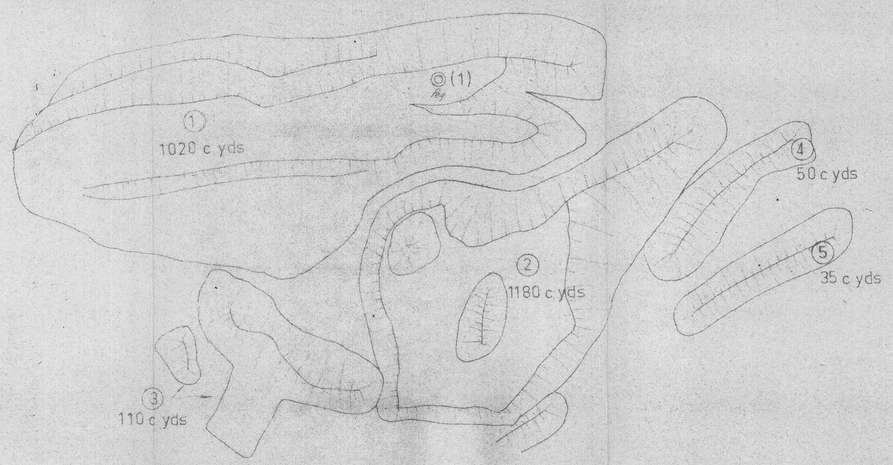

N

5 cm

Q56/59

FIGURE 17

71-793

G.I.FISHER, LAND & ENGINEERING SURVEYOR

TENNECO AUSTRALIA INC

WASTE DUMPS SPRAY AREA

ZEEHAN TASMANIA

835036

1149

APPROVED

SCALE

DRAWN

CHECKED

A0

15/10

N

(1) 7000 c.yds.

NOT SAMPLED

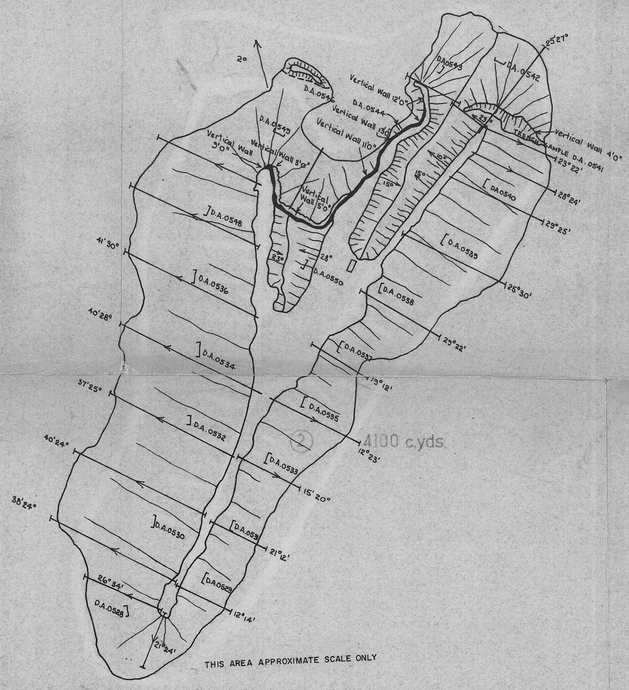

835037

5 cm

71-793 Q50/69

FIGURE 18

G. I. FISHER LAND & ENGINEERING SURVEYOR
LAUNCESTON PHONE 3 4207

TENNECO AUSTRALIA INCORPORATED
WASTE DUMPS, FLORENCE AREA
ZEEHAN, TASMANIA 1150

	SCALE	20' to 1"	NO.
	DRAWN	R. J. P.	15/17
REGISTERED SURVEYOR	CHECKED	G. I. F.	

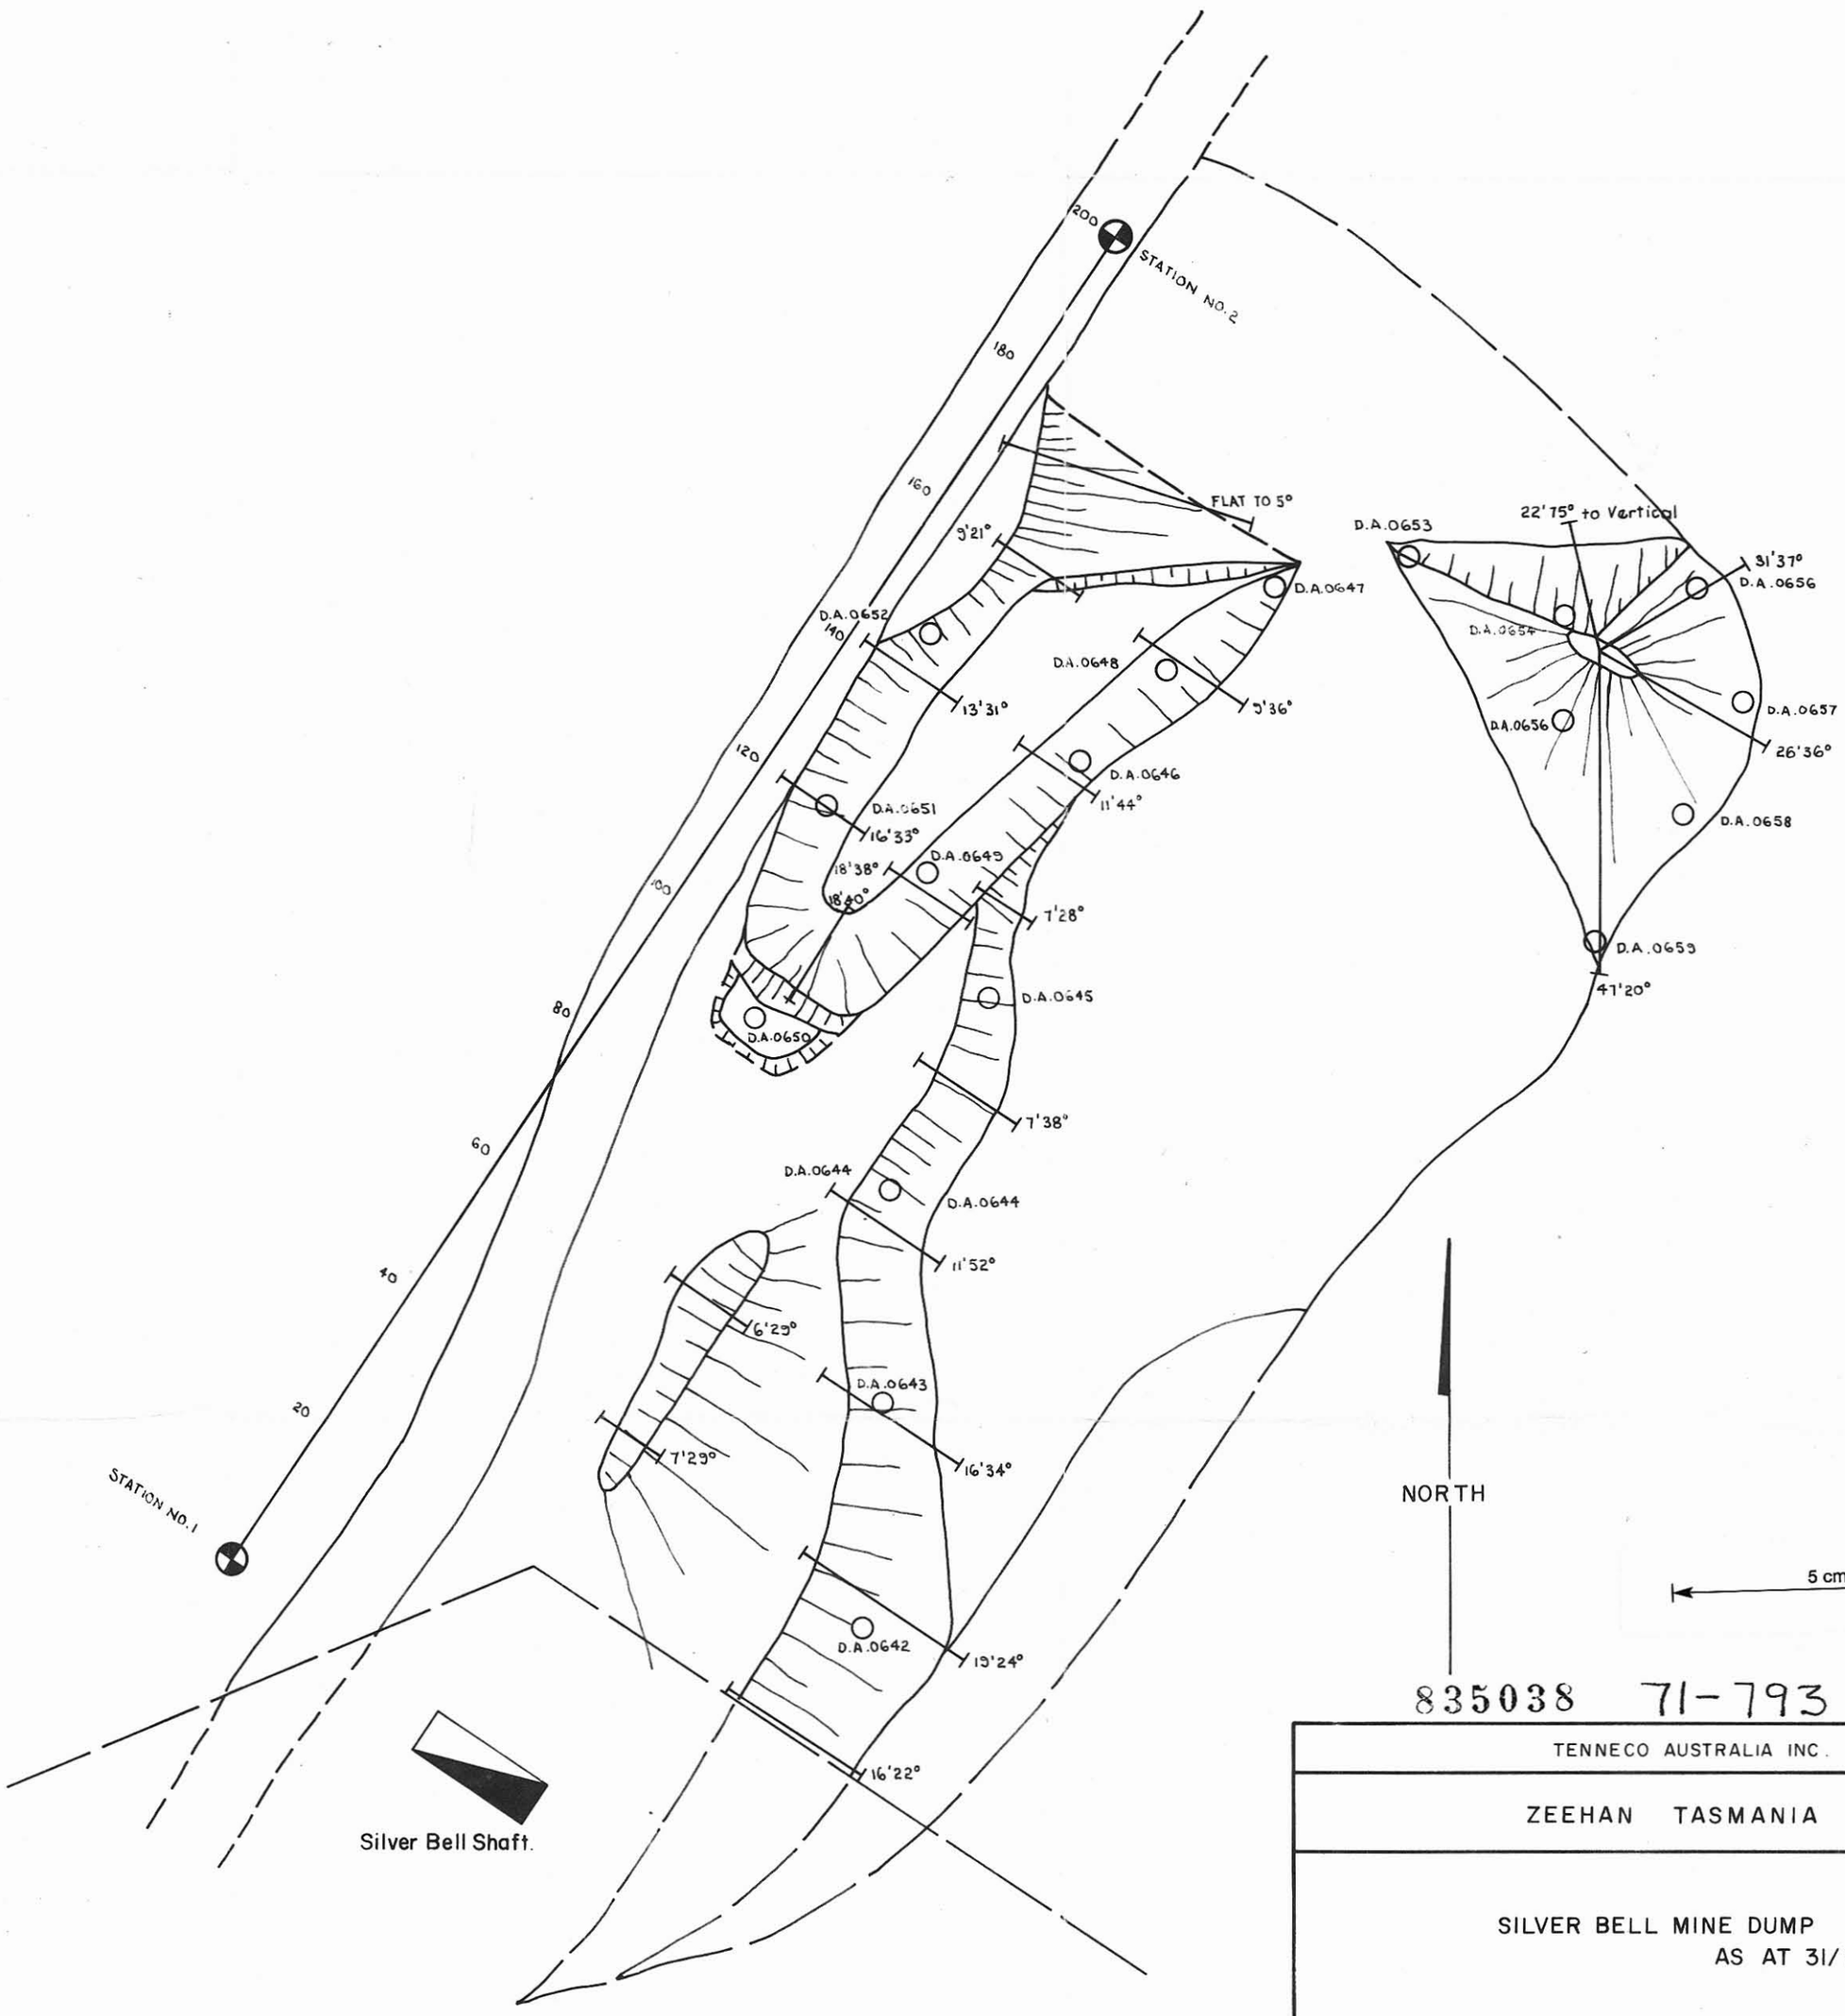

835038 71-793 @50/59

FIGURE 19

TENNECO AUSTRALIA INC.

ZEEHAN TASMANIA

SILVER BELL MINE DUMP
AS AT 31/3/71

1151

DATE : AUG.6 1971	SCALE : 1" = 20'	DWG. NO.
DRAFTED BY : J.M.CURNOW		